


WELL PLUGGING RECORD

Give All Information Completely
Make Required Affidavit
Mail or Deliver Report to:
Conservation Division
State Corporation Commission

P. O. Box 17027
Wichita, Kansas 67217
NORTH

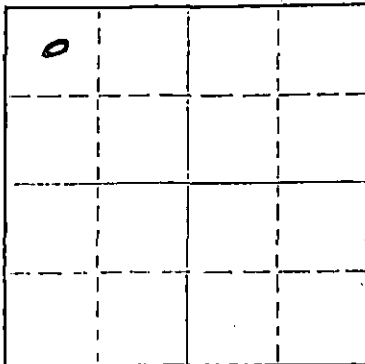

Locate well correctly on above
Section Plat

Morton County, Sec. 11 Twp. 32S Rge. 43W (X) (W) X
C NW NW

Location as "NE/CNW/SW" or footage from lines.
Lease Owner Mr G.F. Collins Jr.

Lease Name Saunders Well No. 1

Office Address Box 520 Sapulpa, Oklahoma 74066

Character of Well (completed as Oil, Gas or Dry Hole) Dry Hole

Date well completed 9-23-74 1974

Application for plugging filed Aug. 27 1974

Application for plugging approved Aug. 29 1974

Plugging commenced 9-20 1974

Plugging completed 9-23 1974

Reason for abandonment of well or producing formation insufficient quantity of hydrocarbons per formation water.

If a producing well is abandoned, date of last production --- 19---

Was permission obtained from the Conservation Division or its agents before plugging was commenced? Yes

Name of Conservation Agent who supervised plugging of this well Clarence Thomas

Producing formation --- Depth to top --- Bottom --- Total Depth of Well 4900 feet

Show depth and thickness of all water, oil and gas formations.

OIL, GAS OR WATER RECORDS

CASING RECORD

| FORMATION | CONTENT | FROM | TO | SIZE | PUT IN | PULLED OUT |
|-----------|-------------|------|------|-------|--------|------------|
| Topeka | water & gas | 3142 | 3183 | 4 1/2 | 3515 | 2608 |
| Lecompton | water & gas | 3274 | 3345 | | | |
| Lansing | water | 3682 | 3983 | | | |
| Marmaton | water | 3983 | 4200 | | | |
| | | | | | | |
| | | | | | | |
| | | | | | | |
| | | | | | | |

Describe in detail the manner in which the well was plugged, indicating where the mud fluid was placed and the method or methods used in introducing it into the hole. If cement or other plugs were used, state the character of same and depth placed, from --- feet to --- feet for each plug set.

Pump 20 sks. of cement @ 3322 to 3067
Pump 50 sks. of cement @ 900 to 800
Put 10 sks. of cement @ 33 to 3

RECEIVED
STATE CORPORATION COMMISSION

SEP 17 1975
1-17-1975
CONSERVATION DIVISION
Wichita, Kansas

Name of Plugging Contractor Sargents Casing Pulling Service Kansas No. 511
Address Box 506 Liberal, Kansas 67901

STATE OF Oklahoma COUNTY OF Creek ss.
I, David Beyer, (employee of owner) or (owner or operator) of the above-described

well, being first duly sworn on oath, says: That I have knowledge of the facts, statements, and matters herein contained and the log of the above-described well as filed and that the same are true and correct. So help me God.

(Signature) David L Beyer

Collins Building, Sapulpa, Oklahoma 74066
(Address)

SUBSCRIBED AND SWORN TO before me this 15th day of January, 1975

My commission expires July 17, 1978

Notary Public.

DRILLER'S LOG

| | |
|-------------------------------|----------------------------|
| LEASE: SAUNDERS #1 | LOCATION: C NW NW |
| OWNER: GEORGE F. COLLINS | SECTION 11-32S-43W |
| CONT: EARL F. WAKEFIELD, INC. | MORTON COUNTY, KANSAS |
| SPUD: 6-1-74 | CASING: 8 5/8" SET @ 1449' |
| COMP: 6-15-74 | 4 1/2" SET @ 3411.40' |

| | |
|-------------------|------|
| P. Rock - Sand | 1012 |
| Gyp - Sand | 1337 |
| Shale & Gyp | 1435 |
| Anhydrite | 1449 |
| Anhydrite & Shale | 2135 |
| Shale, Shells | 2330 |
| Shale | 2658 |
| Shale & Shells | 2740 |
| Shale - Lime | 3396 |
| Shale & Lime | 3510 |
| Shale - Lime | 3695 |
| Shale & Lime | 3790 |
| Shale - Lime | 4044 |
| Lime & Shale | 4145 |
| Shale - Lime | 4343 |
| Shale & Lime | 4631 |
| Shale, Sand | 4755 |
| Shale - Sand | 4900 |
| R.T.D. | 4900 |

RECEIVED
STATE CORPORATION COMMISSION
JAN 17 1975
CONSERVATION DIVISION
Wichita, Kansas

STATE OF KANSAS)
)
COUNTY OF SEDGWICK) ss.

I, Gerald L. Mason, do hereby certify that this is a true and correct log on the Saunders #1, located C NW NW Section 11-32S-43W, Morton County, Kansas, as shown by the daily drilling reports.

EARL F. WAKEFIELD, INC.

By Gerald L. Mason
Gerald L. Mason

Subscribed and sworn to before me this 18th Day of June, 1974.

My Commission Expires:
October 22, 1976

Carol Jean Noel
Carol Jean Noel - Notary Public

