

15-129-00031-0000


STATE OF KANSAS  
STATE CORPORATION COMMISSION

Give All Information Completely  
Make Required Affidavit  
Mail or Deliver Report to:  
Conservation Division  
State Corporation Commission  
800 Bitting Building  
Wichita, Kansas

WELL PLUGGING RECORD

Morton County, Sec. 17 Twp. 32 Rge. (E) 43 (W)

Location as "NE/CNW\*SW\*" or footage from lines C SE SE  
Lease Owner Colorado Oil and Gas Corporation  
Lease Name Huber-Dreyer Well No. 1  
Office Address P. O. Box 999, Liberal, Kansas  
Character of Well (completed as Oil, Gas or Dry Hole) Gas  
Date well completed August 19 58  
Application for plugging filed Yes 19  
Application for plugging approved Yes 19  
Plugging commenced 6-18 19 60  
Plugging completed 6-20 19 60  
Reason for abandonment of well or producing formation Non Commercial

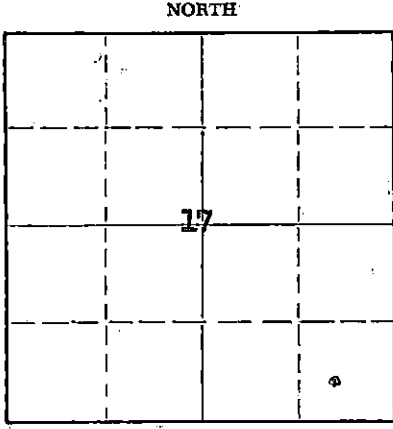

Locate well correctly on above Section Plat

If a producing well is abandoned, date of last production February 19 60  
Was permission obtained from the Conservation Division or its agents before plugging was commenced? Yes

Name of Conservation Agent who supervised plugging of this well W. L. Lackamp  
Producing formation \_\_\_\_\_ Depth to top \_\_\_\_\_ Bottom \_\_\_\_\_ Total Depth of Well 5165 KB Feet  
Show depth and thickness of all water, oil and gas formations. 4321 PFTD

OIL, GAS OR WATER RECORDS

CASING RECORD

FORMATION	CONTENT	FROM	TO	SIZE	PUT IN	PULLED OUT
Anhydrite				12 1/4"	1461	None
Marmaton				5 1/2"	4320	2804

Describe in detail the manner in which the well was plugged, indicating where the mud fluid was placed and the method or methods used in introducing it into the hole. If cement or other plugs were used, state the character of same and depth placed, from 4000 feet to 3980 feet for each plug set.

Filled hole w/sand to 4000'. Cemented w/5 sacks to 3980'. Filled w/mud to 800'. Ran 10' rock bridge w/20 sacks cement on top; mud to 40', 10' rock bridge and cement plug to bottom of cellar, 4' below ground level.

RECEIVED  
STATE CORPORATION COMMISSION

JUN 24 1960

6-24-1960  
CONSERVATION DIVISION  
Wichita, Kansas

(If additional description is necessary, use BACK of this sheet)

Name of Plugging Contractor Knight Casing Pullers  
Address \_\_\_\_\_

STATE OF Kansas COUNTY OF Seward, ss.  
J. A. Ziser (employee of owner) or (owner or operator) of the above-described well, being first duly sworn on oath, says: That I have knowledge of the facts, statements, and matters herein contained and the log of the above-described well as filed and that the same are true and correct. So help me God.

(Signature) J. Ziser  
(Address) \_\_\_\_\_

SUBSCRIBED AND SWORN TO before me this 23rd day of June, 19 60

William B. Claunch  
Notary Public.

My commission expires 11-1-62  
Orig: State Corp. Comm.  
cc: W. L. Lackamp  
J. M. Huber Corp.  
Denver Prod.  
File