


WELL PLUGGING RECORD

Give All Information Completely  
Make Required Affidavit  
Mail or Deliver Report to:  
Conservation Division  
State Corporation Commission  
800 Bittling Building  
Wichita, Kansas

Meade County. Sec. 10 Twp. 34 Rge. 30 (E) (W)  
Location as "NE/CNW/SW" or footage from lines C SE SW  
Lease Owner James Donoghue, et al  
Lease Name Fox Well No. 1  
Office Address 1380 Denver Club Bldg., Denver, Colorado  
Character of Well (completed as Oil, Gas or Dry Hole) Dry Hole  
Date well completed January 22 1956  
Application for plugging filed January 22 1956  
Application for plugging approved January 22 1956  
Plugging commenced January 22 1956  
Plugging completed January 22 1956  
Reason for abandonment of well or producing formation Dry Hole

NORTH

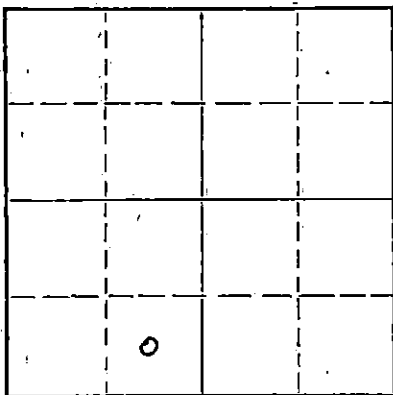

Locate well correctly on above Section Plat

If a producing well is abandoned, date of last production 19  
Was permission obtained from the Conservation Division or its agents before plugging was commenced? Yes

Name of Conservation Agent who supervised plugging of this well M.A. Rives  
Producing formation None Depth to top Bottom Total Depth of Well 6100 Feet  
Show depth and thickness of all water, oil and gas formations.

OIL, GAS OR WATER RECORDS

CASING RECORD

FORMATION	CONTENT	FROM	TO	SIZE	PUT IN	PULLED OUT
Ogallala	Water	0	640	8 5/8	1549'	None

Describe in detail the manner in which the well was plugged, indicating where the mud fluid was placed and the method or methods used in introducing it into the hole. If cement or other plugs were used, state the character of same and depth placed, from feet to feet for each plug set.

6100 to 600' Filled with mud  
600 to 539' Filled with cement  
539 to 35' Filled with mud  
35 to 5' Filled with cement to bottom of cellar.

(If additional description is necessary, use BACK of this sheet)

Name of Plugging Contractor Rocket Drilling Company  
Address Great Bend, Kansas

STATE OF KANSAS, COUNTY OF FINNEY, ss.  
R. W. Lange (employee of owner) or (owner/operator) of the above-described well, being first duly sworn on oath, says: That I have knowledge of the facts, statements, and matters herein contained and the log of the above-described well as filed and that the same are true and correct. So help me God.

(Signature) [Signature]  
Box 134, Garden City, Kansas (Address)


SUBSCRIBED AND SWORN TO before me this 6th day of February, 1956

My commission expires November 1, 1956

[Signature] Notary Public.  
STATE CORPORATION COMMISSION

PLUGGING  
FILE SEC 10 T 34 R 30W  
BOOK PAGE 34 LINE 3

FEB 7 1956  
CONSERVATION DIVISION  
Wichita, Kansas

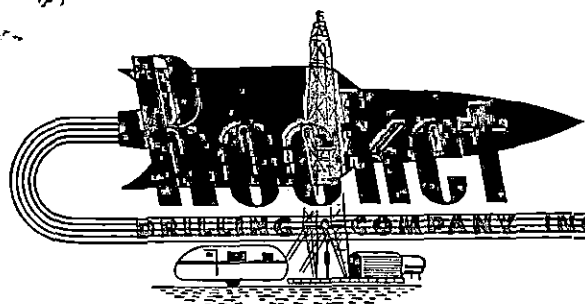

ROCKET DRILLING COMPANY, INC. Forest 3-1279 352 N. BROADWAY WICHITA, KANSAS

James Donoghue  
 #1 Fox  
 C SE/4 SW/4 Sec. 10-34S-30W  
 Meade County, Kansas

Mr. James Donoghue  
 Denver Club Building  
 Denver, Colorado

Elevation:  
 Spudded: December 17, 1955  
 Rotary Completed: January 22, 1956  
 Contractor: Rocket Drilling Company, Inc.

CASING RECORD

1549' 8-5/8" O.D. 24# seamless casing cemented with 750 sacks cement.

DRILLERS LOG

Sand & Gravel	0 to 65	Sandy Shale	1795
Gravel	189	Shale & Shells	2343
Sand & Clay	280	Lime	2425
Sand	296	Shale	2460
Shale	305	Lime & Shale	2749
Sand	315	Lime	3356
Shale	365	Lime & Chalk	3470
Shale & Shells	525	Lime	4082
Sand & Shale	640	Shale	4281
Red Shale	795	Shale & Lime	4409
Sand	805	Shale & Lime Streaks	4482
Shale & Shells	950	Shale & Lime	4548
Anhydrite	1045	Lime	4723
Shale & Shells	1110	Chalk & Lime	4827
Sand	1185	Lime	5373
Anhydrite	1205	Shale & Lime	5521
Sand	1215	Lime	5836
Shale & Shells	1265	Lime & Shale	5915
Sand	1275	Lime	5973
Shale & Shells	1360	Lime & Shale	6005
Shale, Shells & Salt	1530	Shale & Lime	6055
Shale & Shells	1550	Lime	6100 TD
Sand	1635		

STATE OF KANSAS )  
 ) SS  
 COUNTY OF SEDGWICK )

I hereby certify that to the best of my knowledge and belief the foregoing log is true and correct.

ROCKET DRILLING COMPANY, INC.

*L. W. Myrick*  
 L. W. Myrick

Subscribed and sworn to before me, a Notary Public, in and for the County and State aforesaid, this 27th day of January, 1956.

My commission expires:

10/28/1959

*Jessie Helmer Spence*  
 Notary Public

**PLUGGING**  
 FILE SEC 10 T 34 R 30W  
 BOOK PAGE 34 LINE 3

FEB 7 1956

CONSERVATION DIVISION  
 Wichita, Kansas