


STATE OF KANSAS
STATE CORPORATION COMMISSION

WELL PLUGGING RECORD

Give All Information Completely
Make Required Affidavit
Mail or Deliver Report to:
Conservation Division
State Corporation Commission
211 No. Broadway
Wichita, Kansas

Meade County. Sec. 20 Twp. 34 Rge. 29 (X) (W)
Location as "NE/CNW%SW%" or footage from lines NE SW
Lease Owner Thomas & Brewer
Lease Name Adams Well No. 1-20
Office Address Box 1177, Liberal, Kansas
Character of Well (completed as Oil, Gas or Dry Hole) Gas
Date well completed 6-29-60
Application for plugging filed Received oral permission 5-8 19 63
Application for plugging approved 19
Plugging commenced 5-8-63 19
Plugging completed 5-10 19 63
Reason for abandonment of well or producing formation Depleted

NORTH

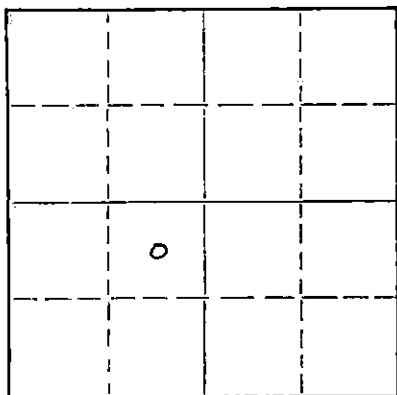

Locate well correctly on above
Section Plat

If a producing well is abandoned, date of last production January 1963
Was permission obtained from the Conservation Division or its agents before plugging was commenced? Yes

Name of Conservation Agent who supervised plugging of this well Hugh Scott
Producing formation Morrow Depth to top Bottom Total Depth of Well 6007 Feet
Show depth and thickness of all water, oil and gas formations.

OIL, GAS OR WATER RECORDS

CASING RECORD

FORMATION	CONTENT	FROM	TO	SIZE	PUT IN	PULLED OUT
Morrow Sand	Gas	5831	5876	8 5/8	1401	None
				5 1/2	6007	3139

Describe in detail the manner in which the well was plugged, indicating where the mud fluid was placed and the method or methods used in introducing it into the hole. If cement or other plugs were used, state the character of same and depth placed, from feet to feet for each plug set.

Pumped 40 sx cement from 5600' to top perforations at 5831. Mud to 700'.
35 sx cement pumped at 700 to 600. Mud to 50' and 15 sx. cement to base
of cellar - Cut 8 5/8 off 3 feet below ground level and weld gap on same

RECEIVED
STATE CORPORATION COMMISSION

MAY 21 1963

CONSERVATION DIVISION
Wichita, Kansas

(If additional description is necessary, use BACK of this sheet)

Name of Plugging Contractor Sargents Casing Pulling Service
Address 121 W. 9th, Liberal, Kansas

STATE OF KANSAS, COUNTY OF SEWARD, ss.
Glenn F. Thomas (employee of owner) or (owner or operator) of the above-described well, being first duly sworn on oath, says: That I have knowledge of the facts, statements, and matters herein contained and the log of the above-described well as filed and that the same are true and correct. So help me God.

(Signature) *Glenn F. Thomas*
Box 1177, Liberal, Kansas
(Address)

SUBSCRIBED AND SWORN TO before me this 17 day of May, 19 63

Margaret Leaton
Notary Public.

My commission expires 11-5-66



THOMAS & BREWER
H. G. Adams #1-20

C/NE NW Sec. 20-31-29
Meade County, Kansas

R.T.D. 6074*
Commenced 4/7/60
Completed 4/30/60

CONTRACTOR: Bennett & Roberts Drilling Co.

Set 1402' of 8 5/8" w/650 sx cmt.
Set 6010' of 6 1/2" w/150 sx cmt.

Surface soil & sand	250'
Sand & Gravel	430
Red Bed & Shale	678
Red Bed & Sand	1380
Anhydrite	1445
Red Bed	1585
Red Bed & Shale	2110
Shale & Lime	2555
Lime	2655
Lime & Shale	2989
Chalky Lime	3349
Lime	3801
Lime & Shale	3930
Shale	4388
Shale & Lime	4690
Lime	6074

STATE OF KANSAS)
RUSSELL COUNTY) SS.

I hereby certify that the above information is correct to the best of my knowledge.

BENNETT & ROBERTS DRILLING CO.

By *Janice Lee Marshall*

Subscribed and sworn to before me this 4th day of May, 1960.

Caru Henne
Notary Public

My Commission Expires 6/17/62

RECEIVED
STATE CORPORATION COMMISSION

MAY 21 1963

CONSERVATION DIVISION
Wichita, Kansas