


15-119-00196-0000

STATE OF KANSAS
STATE CORPORATION COMMISSION
Give All Information Completely
Make Required Affidavit
Call or Deliver Report to:
Conservation Division
State Corporation Commission
800 Bittling Building
Wichita, Kansas

WELL PLUGGING RECORD

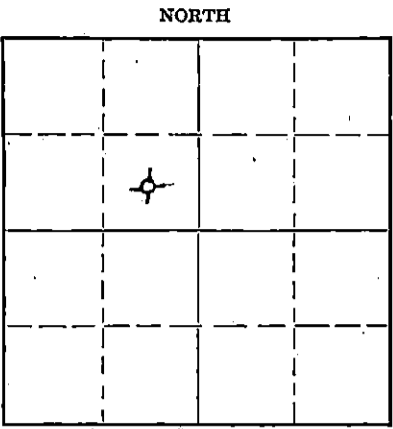

Meade County. Sec 30 Twp. 34 Rge. 34 (E) (W)
Location as "NE/CNW $\frac{1}{4}$ SW $\frac{1}{4}$ " or footage from lines 1980' From N & 1980' From W. Line
Lease Owner Columbian Fuel Corp., United Carbon Co & Helmerich & Payne
Lease Name H.G. Adams Well No. 1-F
Office Address Box 994 Liberal, Kansas
Character of Well (completed as Oil, Gas or Dry Hole) Dry Hole
Date well completed 9-20-51 19.
Application for plugging filed 9-18-51 19.
Application for plugging approved 9-21-51 19.
Plugging commenced 10-18-51 19.
Plugging completed 10-22-51 19.
Reason for abandonment of well or producing formation Non Productive
If a producing well is abandoned, date of last production 19.
Was permission obtained from the Conservation Division or its agents before plugging was commenced? Yes

Locate well correctly on above Section Plot

Name of Conservation Agent who supervised plugging of this well R.J. Phillippe
Producing formation - Depth to top - Bottom - Total Depth of Well 6300' Feet
Show depth and thickness of all water, oil and gas formations.

OIL, GAS OR WATER RECORDS

CASING RECORD

Formation	Content	From	To	Size	Put In	Pulled Out
				9 5/8"	2600'	676'
Sand	Water	0	625	13 3/8"	669'	None

Describe in detail the manner in which the well was plugged, indicating where the mud fluid was placed and the method or methods used in introducing it into the hole. If cement or other plugs were used, state the character of same and depth placed, from...feet to ...feet for each plug set.

- 5950'-6300' Plugged W/Rotary Mud - Pumped
- 5850'-5950' Plugged W/Cement - Pumped
- 4850'-5850' Plugged W/Rotary Mud Pumped
- 4750'-4850' Plugged W/Cement, Pumped
- 2650'-4750' Plugged W/Rotary Mud - Pumped
- 2550'-2650' Plugged W/Cement - Pumped
- 300'-2550' Plugged W/Rotary Mud - Pumped
- 50'-300' Plugged W/Crushed Rock, Dumped
- 15'-50' Plugged W/Cement (35 Sk) Dumped
- 10'-15' Plugged W/Crushed Rock, Dumped
- 0'-10' Plugged W/Cement (10Sks) Dumped,

(If additional description is necessary, use BACK of this sheet)

Correspondence regarding this well should be addressed to Columbian Fuel Corp., Box 994 Liberal, Ks
Address

STATE OF Kansas, COUNTY OF Seward, SS.
(employee of owner) or (owner or operator) of the above-described well,
being first duly sworn on oath, says: That I have knowledge of the facts, statements, and matters herein contained and the log of the above-described well as filed and that the same are true and correct. So help me God.

(Signature) Robert Grady
Box 994 Liberal, Kansas
(Address)

SUBSCRIBED AND SWORN to before me this 25th day of October, 19 51

June 4, 1955

My commission expires

Mellor B. Redign
Notary Public.

PLUGGING
FILE SEC 30 T 34 R 290
BOOK PAGE 40 LINE 40

RECEIVED
STATE CORPORATION COMMISSION

OCT 26 1951

CONSERVATION DIVISION
Wichita

CORP. COMMSU

LOG OF WELL

CODE G. W. 2004 Columbian Fuel Corporation SHEET #1
(COMPANY)
 STATE Kansas DISTRICT #76 COUNTY Meade
 LEASE H. G. Adams WELL NO. #1-F SEC. 30 TWP. 34 R. 29
 DATE OF LOG 10-22-51 LOCATION IN SEC. C. of SE 1/4 of NW 1/4
 LOCATION MADE 6-28-51 COMM. RIGGING UP 7-14-51 COMM. DRILLING 7-18-51 COMP. DRILLING 9-20-51
 TOTAL DEPTH 6300' ELEVATION 2544' STATE PERMIT NO. _____
 DAY DRILLER Abe Hillsberry NIGHT DRILLER L. O. Thompson CONTRACTOR Helmerich & Payne Inc.
 CABLE TOOLS FROM _____ TO _____ ROTARY TOOLS FROM 0 TO 6300'
 OPEN FLOW CAPACITY _____ M. CU. FT. ROCK PRESSURE _____ GASOLINE CONTENT _____ PER M. CU. FT.
 DEPTH IN SAND _____ PRODUCING SANDS AND THICKNESS OF EACH _____
 PRODUCTION FIRST 24 HOURS _____ SETTLED PRODUCTION _____ STARTED PRODUCTION _____
 DATE TUBED _____ SYPHON SET _____ SIZE _____ FEET _____

CASING RECORD

SIZE	WEIGHT	PUT IN WELL		PULLED OUT		LEFT IN WELL		SHOES		PACKERS	
		FEET	IN.	FEET	IN.	FEET	IN.	LENGTH	MAKE	KIND	LENGTH
13 3/8"	36#	669'	-			669'		None			
	36#	1800		269'		1531'					
9 5/8"	25.4#	800		400'		400'		Guide Shoe		Float Collar	

LINER: STATE SIZE AND WEIGHT _____ WHERE SET _____ FT. AND INS. BLANK _____ FT. AND INS. PERFORATED _____
 HOW PUT TOGETHER _____ COUPLING _____ FLUSH-JOINT _____ INSERTED _____
 REMARKS _____

EQUIPMENT RECORD

TUBING				SUCKER RODS			PUMPING OUTFIT
SIZE	WEIGHT	FEET	IN.	FEET	IN.	SIZE AND KIND	DESCRIPTION, KIND, SIZE, ETC.

KIND OF SHOT _____ SIZE OF SHOT QUARTS _____ NUMBER OF SHOTS _____
 NUMBER OF SHELLS _____ SIZE OF SHELLS _____ INCHES, DIAMETER _____
 LENGTH OF SHELLS _____ FT. _____ INS. SHOT FURNISHED BY _____ TOP OF SHOT _____
 BOTTOM OF SHOT _____ ANCHOR _____
 PRODUCTION BEFORE SHOT _____ PRODUCTION AFTER SHOT _____
 NAME OF SHOOTER _____ SHOT INSPECTED _____
 COMMENCED DRILLING DEEPER _____ COMPLETED DRILLING DEEPER _____
 TOTAL DEPTH _____ PRODUCTION FIRST 24 HOURS _____ SETTLED PRODUCTION _____

WELL BRIDGED TO _____
 STATE CORP. _____
 OCT 26 1951
 CONSERVATION DIVISION
 Wichita, Kansas
 (COMPANY EMPLOYEE)

REMARKS: Dry Hole - Plugged by C.F.C. using Halliburton & J.R. Barnes & Sons - Contractors -
In accordance W/Regulations of State Corporation Comm. - Completed 10-22-51

NOTE: IF WELL WAS DRY, STATE UNDER REMARKS WHEN, HOW, AND BY WHOM PLUGGED.
 IF SPACE PROVIDED FOR REMARKS ANYTHING OF INTEREST NOT COVERED IN LOG.
 IF SPACE PROVIDED FOR REMARKS IS NOT SUFFICIENT WRITE ON BOTTOM OF LAST SHEET OF LOG.

PLUGGED
 FILE SEC 30 1.34 R 29
 BOOK PAGE 110 LINE 4

H. G. Adams F-1
NW Section 30-34S-29W
Meade County, Kansas
Columbian Fuel Corporation

Commenced: July 18, 1951
 Completed: September, 19, 1951

Surface Sand & Clay	0	625	Lime & Shale Cherty	4953	5028
Redbed	625	733	Chert, Lime & Shale	5028	5079
Redbed & Anhydrite	733	780	Lime & Shale	5079	5111
Redbed	780	895	Cherty Lime & Shale	5111	5164
Redbed & Shells	895	967	Lime & Shale Sandy	5164	5170
Redbed & Sand	967	1106	Lime & Shale	5170	5220
Redbed & Shells	1106	1180	Lime	5220	5223
Redbed, Shale, Shells & Gyp	1180	1260	Lime & Shale	5223	5275
Redbed, Lime & Gyp	1260	1302	Lime	5275	5278
Redbed, Gyp, Lime & Salt	1302	1332	Lime & Shale, Cherty	5278	5308
Redbed, Gyp & Salt	1332	1393	Lime & Shale	5308	5325
Redbed & Lime Shells	1393	1497	Lime & Shale, Cherty	5325	5336
Redbed, Gyp, Lime & Anhydrite	1497	1522	Lime & Shale	5336	5361
Redbed, Shale, Gyp & Lime	1522	1572	Lime	5361	5373
Redbed, Shale & Lime	1572	1602	Lime & Shale	5373	5423
Shale & Lime	1602	1633	Cherty Lime & Shale	5423	5432
Anhydrite, Lime & Shale	1633	1719	Lime & Shale	5432	5508
Shale & Lime	1719	1756	Shale & Lime Shells	5508	5528
Shale, Lime & Salt	1756	1897	Shale & Lime	5528	5540
Shale & Lime	1897	2225	Shale	5540	5554
Lime, Shale & Anhydrite	2225	2375	Shale & Lime	5554	5836
Anhydrite, Lime, Shale & Salt	2375	2453	Shale	5836	5845
Lime, Anhydrite & Shale	2453	2484	Sand & Shale	5845	5855
Anhydrite, Shale & Chalky Lime	2484	2497	Limey Sand & Shale	5855	5874
Lime, Anhydrite & Shale	2497	2654	Lime & Shale	5874	5914
Lime & Chert	2654	2679	Shale	5914	5923
Cherty Lime & Shale	2679	2729	Shale, Sand & Chert	5923	5941
lime & Shale	2729	3055	Shale & Sand	5941	5956
Lime & Chert	3055	3124	Sand	5956	5959
Lime	3124	3141	Lime & Shale Sandy	5959	5982
Lime, Cherty	3141	3152	Shale & Lime	5982	6226
Lime & Shale	3152	3160	Lime & Shale, Sandy	6226	6289
Cherty Lime & Shale	3160	3166	Lime & Shale	6289	6300
Lime	3166	3282	TOTAL DEPTH	6300	
Lime & Shale	3282	3561			
Sandy Lime	3561	3586			
Lime & Shale	3586	3600			
Soft Lime	3600	3612			
Lime & Shale	3612	3619			
Sandy porous Lime & Chalky	3619	3626			
Lime	3626	3673			
Lime & Shale	3673	3824			
Shale	3824	4020			
Shale & Lime	4020	4056			
Shale	4056	4119			
Shale & Lime	4119	4464			
Broken Sandy Shale	4464	4495			
Lime	4495	4545			
Lime & Shale	4545	4928			
Cherty Lime & Shale	4928	4953			

CASING RECORD

Set 13-3/8" Casing 669' with 500 sacks
 Set 9-5/8" Casing @ 2600 with 1000 sacks

STATE OF OKLAHOMA)
)
 COUNTY OF TULSA)

I hereby affirm that the above and foregoing is a true and correct copy of the log of the H. G. Adams F-1 Well located in the Northwest Quarter of Section 30, Township 34 South, Range 29 West, Meade County, Kansas.

HELMERICH & PAYNE, INC.

By *J. H. Payne*
 Vice-President

Subscribed and sworn to before me this 3rd day of October, 1951.

RECEIVED
 STATE CORPORATION COMMISSION
 OCT 26 1951
 CONSERVATION DIVISION
 Wichita, Kansas

Charles H. Smith
 Notary Public

My commission expires March 13, 1954.