


STATE OF KANSAS
STATE CORPORATION COMMISSION
Give All Information Completely
Make Required Affidavit
Mail or Deliver Report to:
Conservation Division
State Corporation Commission
211 No. Broadway
Wichita, Kansas

WELL PLUGGING RECORD

Meade County, Sec. 12 Twp. 34 Rge. 27 (E) (W)
Location as "NE/CNW&SW" or footage from lines C-NE NE
Lease Owner Alamo Corporation SE
Lease Name Isaac Well No. 1
Office Address 1006 Lubbock National Bank Bldg., Lubbock, Texas
Character of Well (completed as Oil, Gas or Dry Hole) Dry Hole
Date well completed 6/17/57 19 57
Application for plugging filed 6/22/57 (verbally) 19 57
Application for plugging approved 6/22/57 (verbally) 19 57
Plugging commenced 6/23/57 19 57
Plugging completed 7/1/57 19 57
Reason for abandonment of well or producing formation well would not produce commercially

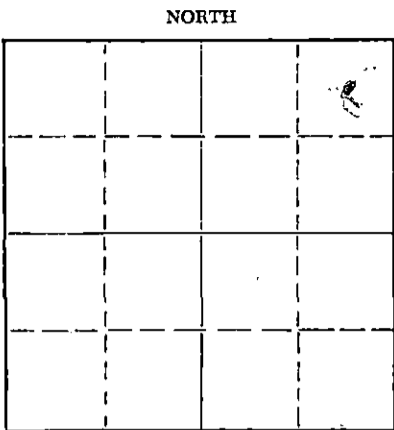

Locate well correctly on above Section Plat

If a producing well is abandoned, date of last production _____ 19____
Was permission obtained from the Conservation Division or its agents before plugging was commenced? Yes

Name of Conservation Agent who supervised plugging of this well Richard Phillippe
Producing formation Chester Depth to top 6004 Bottom 6012 Total Depth of Well 6175 Feet
Show depth and thickness of all water, oil and gas formations.

OIL, GAS OR WATER RECORDS

CASING RECORD

FORMATION	CONTENT	FROM	TO	SIZE	PUT IN	PULLED OUT
Chester	625	6004	6012	13 3/8	280	None
				8 5/8	2645	1804
				5 1/2	6090	5425

Describe in detail the manner in which the well was plugged, indicating where the mud fluid was placed and the method or methods used in introducing it into the hole. If cement or other plugs were used, state the character of same and depth placed, from _____ feet to _____ feet for each plug set.

The hole was clean after abandonment with perfs 6004-12 open. 20 sacks of cement were pumped in with plug behind. The plug was pumped to 5880', 5 1/2" casing was then shot off at 5425 and pulled. 8 1/8" casing was then shot off at 1804 and pulled. Hole was then filled to 275' with heavy mud and plug was set at 275' with 20 sacks of cement on top. Hole was then filled to 20' with heavy mud. A plug was set at 20' with a wire line and hole was then filled to cellar with cement.

(If additional description is necessary, use BACK of this sheet)

Name of Plugging Contractor Daco Lease and Well Service
Address Borger, Texas

STATE OF Kansas, COUNTY OF Seward, ss.
Lloyd Henderson (employee of owner) or ~~(owner or operator)~~ of the above-described well, being first duly sworn on oath, says: That I have knowledge of the facts, statements, and matters herein contained and the log of the above-described well as filed and that the same are true and correct. So help me God.

(Signature) Lloyd Henderson
Box 985, Liberal, Kansas (Address)

SUBSCRIBED AND SWORN TO before me this 3rd day of July, 19 57

My commission expires March 1, 1961

Marta Clark
Notary Public.

PLUGGING
FILE SEC. 12 T. 34 R. 27W
BOOK PAGE 27 LINE 25

RECEIVED
STATE CORPORATION COMMISSION

JUL 11 1957
CONSERVATION DIVISION
Wichita, Kansas