

RECEIVED

SEP 15 1976


AMA. PROD.

Form 11-1

STATE OF KANSAS
STATE COORDINATION COMMISSION

Also All Information Completely
State Department of
Revenue Before Proceeding
Conservation Division
State Conservation Commission
P. O. Box 17027
Wichita, Kansas 67217

WELL PLUGGING RECORD

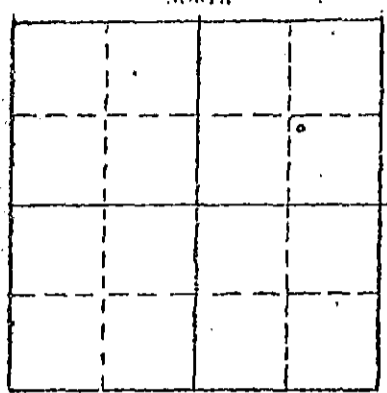

Locate well correctly on above
Section Plat

Clark County, Sec. 19 Twp. 34S. Rge. 24W (E) (W)
Location as "NE/CNWSW" or footage from lines 1400' FNL & 1250 FFL
Lease Owner Mesa Petroleum Company
Lease Name Klinger Well No. 1-19
Office Address Box 2009, Amarillo, Texas 79105
Character of Well (completed as Oil, Gas or Dry Hole) dry
Date well completed 9-9-76 19
Application for plugging filed 19
Application for plugging approved 19
Plugging commenced 9-11-76 10
Plugging completed 9-11-76 19
Reason for abandonment of well or producing formation dry hole

If a producing well is abandoned, date of last production ----- 19
Was permission obtained from the Conservation Division or its agents before plugging was commenced? Yes

Name of Conservation Agent who supervised plugging of this well Leo Massey - unable to reach Clarence Thomas
Producing formation ----- Depth to top -- Bottom -- Total Depth of Well 6030 Feet
Show depth and thickness of all water, oil and gas formations.

OIL, GAS OR WATER RECORDS

CASING RECORD

FORMATION	CONTENT	FROM	TO	SIZE	PUT IN	PULLED OUT
				9 5/8"	1022'	none

Describe in detail the manner in which the well was plugged, indicating where the mud fluid was placed and the method or methods used in introducing it into the hole. If cement or other plugs were used, state the character of same and depth placed, from ----- feet to ----- feet for each plug set.

Plugged as follows with 50/50 pozmix cement: 45 sacks 975-869'
10 sacks 30-3'
5 sacks each mouse & rat holes

FILED
SEP 20 1976
CONSERVATION DIVISION
Wichita, Kansas

Name of Plugging Contractor, Halliburton (If additional description is necessary, use BACK of this sheet)
Address P. O. Box 112, Liberal, Kansas 67901

STATE OF TEXAS COUNTY OF POTTER ss.
S. E. Dobler, Mesa Petroleum Co. (employe of owner) or (owner or operator) of the above-described

well, being first duly sworn on oath, says: That I have knowledge of the facts, statements, and matters herein contained and the log of the above-described well as filed and that the same are true and correct. So help me God.
(Signature) S. E. Dobler

P. O. Box 2009, Amarillo, Texas 79105
(Address)

Subscribed and Sworn to before me this 22nd day of September 1976

Dorothy Randle
Dorothy Randle Notary Public.

My commission expires 6/1/77

XC: KCC (2), Denver Office (1), File

15-025-20123-0000 RECEIVED

WELL LOG SEP 20 1976

JLF	
SD	
GD	
TLS	

AMA. PROD.

COMPANY MESA PETROLEUM COMPANY

SEC. 19 T. 34S R. 24W

FARM KLINGER NO. 1-19

LOG. 1400' FNL & 1250' FEL

TOTAL DEPTH 6030

COUNTY CLARK, KANSAS

COMM. 8-26-76

COMP. 9-8-76

CONTRACTOR DRILLERS, INC.

CASING

9-5/8" @ 1029

ELEVATION 2000' GL, 2009' DF, 2010' KB

PRODUCTION D & A

FIGURES INDICATE BOTTOM OF FORMATIONS

0 - 1063	LIME & SHALE
1063 - 1718	RED BED & SHALE
1718 - 2614	ANHYDRITE & DOLOMITE
2614 - 6030	LIME & SHALE

RECEIVED STATE CORPORATION COMMISSION

SEP 29 1976

CONSERVATION DIVISION Wichita, Kansas

State of TEXAS
County of HARRIS } SS

I, MITCH M. ASMAR of HOUSTON, TEXAS

upon oath state the above and foregoing is a true and correct copy of the log of the KLINGER # 1-19 well.

Mitchell M. Asmar

Subscribed and sworn to before me this 16th day of September 19 76

My Commission Expires: June 1, 1977

Judy Wells
NOTARY PUBLIC

XC: KGS (1), Denver Office, File