


STATE OF KANSAS  
STATE CORPORATION COMMISSION  
CONSERVATION DIVISION  
P. O. BOX 17027  
WICHITA, KANSAS 67217

FORM CP-4

WELL PLUGGING RECORD

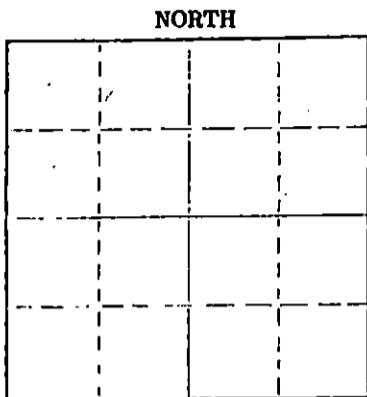

Locate well correctly on above Section Plat

KIOWA County, Sec. 5 Twp. 29S Rge. (E) 20 (W)  
Location as "NE/CNW/SW" or footage from lines: 1410' FSL & 1320' FWL  
Lease Owner Texas Oil & Gas Corp.  
Lease Name MANKE "A" Well No. 1  
Office Address 200 W. Douglas, Suite 300, Wichita, KS. 67202  
Character of Well (completed as Oil, Gas or Dry Hole) Dry Hole  
Date well completed 10-23-77 19  
Application for plugging filed 10-23-77 19  
Application for plugging approved 10-23-77 19  
Plugging commenced 10-23-77 19  
Plugging completed 10-23-77 19  
Reason for abandonment of well or producing formation

If a producing well is abandoned, date of last production 19  
Was permission obtained from the Conservation Division or its agents before plugging was commenced? Yes

Name of Conservation Agent who supervised plugging of this well Bill Owens  
Producing formation Depth to top Bottom Total Depth of Well 5175  
Show depth and thickness of all water, oil and gas formations.

OIL, GAS OR WATER RECORDS

CASING RECORD

FORMATION	CONTENT	FROM	TO	SIZE	PUT IN	PULLED OUT
		0	550'	8 5/8		
RECEIVED STATE CORPORATION COMMISSION NOV 02 1977 11-2-77 CONSERVATION DIVISION Wichita, Kansas						

Describe in detail the manner in which the well was plugged, indicating where the mud fluid was placed and the method or methods used in introducing it into the hole. If cement or other plugs were used, state the character of same and depth placed, from feet to feet for each plug set.

Heavy mud to 550', 1/2 sacks hulls, 40 sacks,  
Plug bridged 12 sacks to surface 3 sacks  
in rat hole.

OCT 31 1977

CONSERVATION DIVISION  
Wichita, Kansas

(If additional description is necessary, use BACK of this sheet)

Name of Plugging Contractor Xplor Drilling Co.  
Address 453 S. Rock Road, Wichita, Kansas 67107


STATE OF KANSAS COUNTY OF SEDGWICK  
Kriby C. Evers (employee of owner) or (owner or operator) of the above-described

well, being first duly sworn on oath, says: That I have knowledge of the facts, statements, and matters herein contained and the log of the above-described well as filed and that the same are true and correct. So help me God.

(Signature) *[Signature]*  
453 S. Webb Rd. Wichita, KS. 67207  
(Address)

Subscribed and sworn to before me this 27 day of October 19 77

My commission expires August 25, 1977  
Virginia Lee Smith Notary Public.

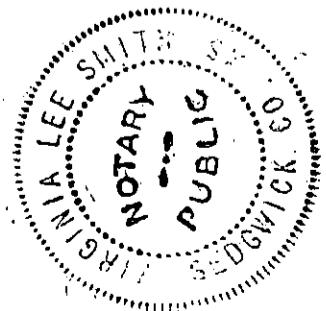

WELL      LOG

MANKE "A" #1  
1410 FSL & 1320 FWL  
 Section 5-29S-20W  
 Kiowa County, Kansas

OPERATOR:            TEXAS OIL & GAS CORP.            COMMENCED: 10-14-77  
 CONTRACTOR:        XPLOR DRILLING CO.                COMPLETED: 10-23-77

CASING RECORD:     Ran 15 jts. new 8 5/8", set @550, cement with 550 sacks  
 common cement, 2% gel. 3% cal.chloride.

<u>FORMATION</u>	<u>FROM</u>	<u>TO</u>	<u>ELEVATION</u>
Red Bed & Shale	0	1245	
Lime & Shale	1245	4788	
Lime	4788	4905	
Lime & Shale	4905	5042	
Lime	5042	5175	
R.T.D.	5175		

STATE OF KANSAS        )  
                                   ) SS:  
 COUNTY OF SEDGWICK    )

I certify that this is a true and correct copy of the Driller's Log of the well drilled 1410 FSL & 1320 FWL of Section 5-29S-20W, Kiowa County, Kansas, to the best of my knowledge and belief.

XPLOR DRILLING CO.

*Kirby C. Every*  
 Kirby C. Every, Vice-President

Subscribed and sworn to before me this 27th. day of October, 1977.

MY COMMISSION EXPIRES:  
 August 25, 1980

*Virginia Lee Smith*  
 Virginia Lee Smith, Notary Public

