


STATE OF KANSAS  
STATE CORPORATION COMMISSION

Form CP-4

WELL PLUGGING RECORD

Give All Information Completely  
Make Required Affidavit  
Mail or Deliver Report to:  
Conservation Division  
State Corporation Commission  
212 No. Market  
Wichita, Kansas 67202

Kiowa County, Sec. 29 Twp. 29S. Rge. (E) 19 (W)  
Location as "NE/CNW/SW" or footage from lines C SW NE  
Lease Owner O. A. Sutton  
Lease Name J. R. Thach Well No. 1  
Office Address 800 Sutton Place, Wichita, Kansas  
Character of Well (completed as Oil, Gas or Dry Hole) Dry Hole  
Date well completed January 30 1974  
Application for plugging filed January 30 1974  
Application for plugging approved January 30 1974  
Plugging commenced January 30 1974  
Plugging completed January 30 1974  
Reason for abandonment of well or producing formation

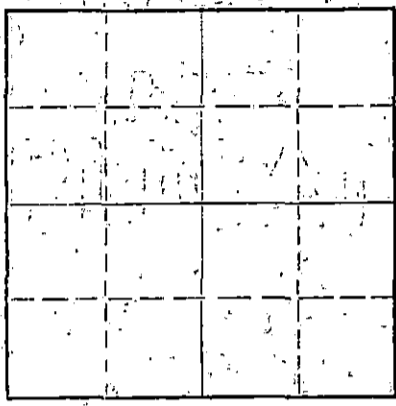

Locate well correctly on above  
Section Plat

If a producing well is abandoned, date of last production 19  
Was permission obtained from the Conservation Division or its agents before plugging was commenced? Yes

Name of Conservation Agent who supervised plugging of this well G. Russell Biberstein  
Producing formation Depth to top Bottom Total Depth of Well 5199 Feet  
Show depth and thickness of all water, oil and gas formations.

OIL, GAS OR WATER RECORDS

CASING RECORD

FORMATION	CONTENT	FROM	TO	SIZE	PUT IN	PULLED OUT
				8-5/8"	576'	

Describe in detail the manner in which the well was plugged, indicating where the mud fluid was placed and the method or methods used in introducing it into the hole. If cement or other plugs were used, state the character of same and depth placed, from feet to feet for each plug set.

1st plug at 500' with 45 sacks. 2nd plug at 40' with 15 sacks.  
25 sacks in rat hole. Job complete at 9:30 a.m. 1-30-74.

RECEIVED  
STATE CORPORATION COMMISSION  
FEB 6 1974  
CONSERVATION DIVISION  
Wichita, Kansas

(If additional description is necessary, use BACK of this sheet)  
Name of Plugging Contractor Gabbert-Jones, Inc.  
Address 830 Sutton Place, Wichita, Kansas

STATE OF KANSAS COUNTY OF SEDGWICK, ss.  
Jack G. Paulsen (employee of owner) or (owner or operator) of the above-described

well, being first duly sworn on oath, says: That I have knowledge of the facts, statements, and matters herein contained and the log of the above-described well as filed and that the same are true and correct. So help me God.

(Signature) Jack G. Paulsen  
830 Sutton Place, Wichita, Kansas  
(Address)

Subscribed and sworn to before me this 5th day of February, 1974.

My commission expires June 28, 1974. Jean S. Taylor Notary Public.

