


WELL PLUGGING RECORD

Give All Information Completely
Make Required Affidavit
Mail or Deliver Report to:
Conservation Division
State Corporation Commission
211 No. Broadway
Wichita, Kansas

NORTH

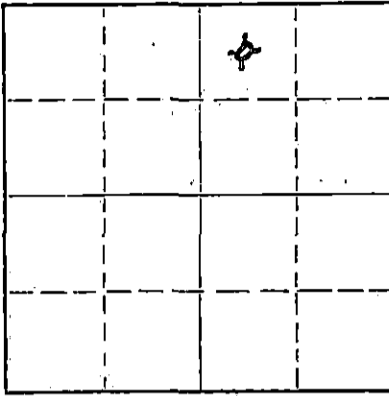

Locate well correctly on above
Section Plat

Kiowa County, Sec. 28 Twp. 29S Rge. (E) 19 (W)
Location as "NE/CNWxSWx" or footage from lines Ctr. NW NE
Lease Owner Champlin Oil & Refining Co.
Lease Name Georgia Eubank Well No. 1
Office Address P.O. Box 308, Ellinwood, Kansas
Character of Well (completed as Oil, Gas or Dry Hole) Dry Hole
Date well completed January 19 19 63
Application for plugging filed January 22 19 63
Application for plugging approved January 24 19 63
Plugging commenced February 2 19 63
Plugging completed February 4 19 63
Reason for abandonment of well or producing formation

If a producing well is abandoned, date of last production 19
Was permission obtained from the Conservation Division or its agents before plugging was commenced? Yes

Name of Conservation Agent who supervised plugging of this well Archie V. Elving
Producing formation Depth to top Bottom Total Depth of Well 5205 Feet
Show depth and thickness of all water, oil and gas formations.

OIL, GAS OR WATER RECORDS

CASING RECORD

FORMATION	CONTENT	FROM	TO	SIZE	PUT IN	PULLED OUT
				8 5/8" OD	665'	None
				4 1/2"	5193'	4960'

Describe in detail the manner in which the well was plugged, indicating where the mud fluid was placed and the method or methods used in introducing it into the hole. If cement or other plugs were used, state the character of same and depth placed, from feet to feet for each plug set.

Filled hole with sand from 5150 to 5130 and
3 sacks of cement from 5130 to 5100. Mud from
5100' and to 200' and rock from 200 to 190'.
20 sacks cement from 190 to 130 and mud from
130 to 40'. Rock bridge and 10 sacks of cement
from 40' to bottom of cellar.

RECEIVED
STATE CORPORATION COMMISSION

FEB 8 1963

CONSERVATION DIVISION
Wichita, Kansas

(If additional description is necessary, use BACK of this sheet)

Name of Plugging Contractor Glenn & Smith Pipe Pulling Co.
Address Ellinwood, Kansas

STATE OF Kansas, COUNTY OF Barton, ss.
J. W. Meyers (employee of owner) or (owner or operator) of the above-described well, being first duly sworn on oath, says: That I have knowledge of the facts, statements, and matters herein contained and the log of the above-described well as filed and that the same are true and correct. So help me God.

(Signature) *J. W. Meyers*

Box 308, Ellinwood, Kansas
(Address)

SUBSCRIBED AND SWORN TO before me this 7th day of February, 19 63

M. A. Kennedy
Notary Public.

My commission expires 5-22-66

KANSAS GEOLOGICAL SOCIETY
KANSAS WELL LOG BUREAU - KANSAS WELL SAMPLE BUREAU
KANSAS GEOLOGICAL SOCIETY BUILDING
508 EAST MURDOCK - WICHITA, KANSAS

COMPANY Champlin Oil & Refining Co.


SEC. 28 T. 29S R. 19W
LOC. C NW NE

FARM Eubank NO. 1

TOTAL DEPTH 5,202'
COMM. 12-8-62
SHOT OR TREATED
CONTRACTOR H-30, Inc.
ISSUED

RECEIVED
CORPORATION COMMISSION COUNTY Kiowa
COMP. 12-31-62

JAN 24 1963
CONSERVATION DIVISION
Wichita, Kansas

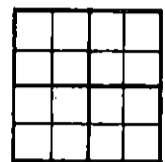

CASING
20 10 2374 GR
15 5/8" 665 cem w/300 sx ELEVATION 2376 DF
12 6 2379 KB
13 1/2" 5193' cem w/50 sx 50/50 Pozmix PRODUCTION
25# Gilsonite per sack
FIGURES INDICATE BOTTOM OF FORMATIONS

Top Soil, Shale & Shells	265	Electric Log Tops	
Red Bed, Shale & Shells	550		
Shale & Shells	665	Herington	2660 - 284
Red Bed, Shale & Shells	1220	Krider	2692 - 316
Shale & Shells	1270	Winfield	2765 - 389
Anhydrite	1300	Ft. Riley	2835 - 459
Shale & Shells	1580	Wreford	3040 - 664
Shale & Lime	1720	Council Grove	3084 - 708
Shale & Shells	2360	Admire	3532 -1156
Lime & Shale	2640	Wabaunsee	3668 -1292
Lime	2715	Topeka	3874 -1498
Lime & Shale	3265	Heebner	4327 -1951
Shale & Lime	3870	Toronto	4345 -1969
Lime & Shale	3919	Douglas	4359 -1983
Lime	3980	Lansing	4500 -2124
Lime & Shale	4125	Base K. C.	4928 -2552
Lime	4259	Marmaton	4948 -2572
Lime & Shale	4495	Cherokee	5057 -2681
Lime	2915	Base Penn.	5110 -2734
Lime & Shale	5025	Miss. Warsaw	5129 -2753
Lime	5202	Osage	5176 -2800
Rotary Total Depth	5202	Log T. D.	5205 -2829

I hereby certify that the above and foregoing is a true and correct log of the above described well as shown by the drilling reports.

H-30, INC.

Priscilla M. Ismert
Priscilla M. Ismert

STATE OF KANSAS)
) ss:
SEDGWICK COUNTY)

Subscribed and sworn to before me, a Notary Public in and for said county and state, this 2nd day of January, 1963.

Geraldine Hays
Geraldine Hays, Notary Public

My Commission Expires:
December 3, 1964.

