


STATE OF KANSAS  
STATE CORPORATION COMMISSION

WELL PLUGGING RECORD

Give All Information Completely  
Make Required Affidavit  
Mail or Deliver Report to  
Conservation Division  
State Corporation Comm.  
245 North Water  
Wichita, KS 67202

Kiowa County. Sec. 23 Twp. 29S Rge. 19W E/W  
Location as "NE/CNW 1/4 SW 1/4" or footage from lines 1230' from  
the So. line, 330' from the East line of Section  
Lease Owner Wells Energy Corp.  
Lease Name Shook Well No. 1  
Office Address 700 S. Colorado, Suite 454, Denver, Co.  
Character of Well (Completed as Oil, Gas or Dry Hole) DRY HOLE

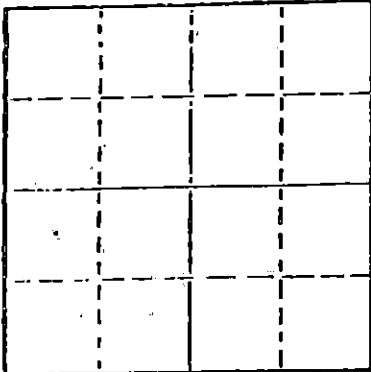

Locate well correctly on above  
Section Plot

Date Well completed 12-4 1979  
Application for plugging filed 12-4 1979  
Application for plugging approved 12-4 1979  
Plugging commenced 12-4 1979  
Plugging completed 12-4 1979  
Reason for abandonment of well or producing formation

If a producing well is abandoned, date of last production 19

Was permission obtained from the Conservation Division or  
its agents before plugging was commenced? Yes

Name of Conservation Agent who supervised plugging of this well Bill Owen  
Producing formation Depth to top Bottom Total Depth of Well  
Show depth and thickness of all water, oil and gas formations.

OIL, GAS OR WATER RECORDS

CASING RECORD

FORMATION	CONTENT	FROM	TO	SIZE	PUT IN	PULLED OUT
		0	750'	8 5/8	17jts.	

Describe in detail the manner in which the well was plugged, indicating where the mud fluid  
was placed and the method or methods used in introducing it into the hold. If cement or other  
plugs were used, state the character of same and depth placed, from feet to  
feet for each plug set.

Plugged hole at 690' with 50 sacks of cement and 40' with 8 1/2 sh. hulls,  
1 wooden plug, 10 sacks of cement and 5 sack in the rat hole.

STATE RECEIVED  
CONSERVATION DIVISION  
DEC 15 1979  
12-13-79

(If additional description is necessary, use BACK of this sheet)  
Name of Plugging Contractor Halliburton

STATE OF Kansas COUNTY OF Sedgwick, ss.  
Kirby C. Evers (employee of owner) or (owner or operator)  
of the above-described well, being first duly sworn on oath, says: That I have knowledge of  
the facts, statements, and matters herein contained and the log of the above-described well  
as filed and that the same are true and correct. So help me God.

(Signature) Kirby C. Evers  
P.O. Box 18611, Wichita, Kansas  
(Address)

SUBSCRIBED AND SWORN TO before me this 12th day of December, 1979

My commission expires MY APPOINTMENT EXPIRES NOV 28, 1980  
Mary Kay Oeding Notary Public.