


Give All Information Completely  
Make Required Affidavit  
Mail or Deliver Report to:  
Conservation Division  
State Corporation Commission  
211 No. Broadway  
Wichita, Kansas

WELL PLUGGING RECORD

Kiowa County, Sec. 17 Twp. <sup>29</sup> ~~28~~ Rge. 19 (E) (W) X

NORTH

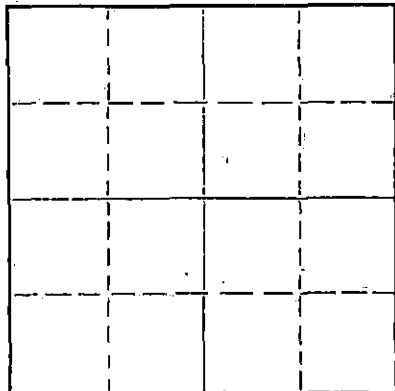

Locate well correctly on above  
Section Plat

Location as "NE/CNW/SW" or footage from lines. SE 1/4  
Lease Owner Sunray DX Oil Company  
Lease Name A. B. Sidener Well No. 1  
Office Address P. O. Box 381 Pratt, Kansas  
Character of Well (completed as Oil, Gas or Dry Hole) \_\_\_\_\_  
Date well completed \_\_\_\_\_ 19\_\_\_\_  
Application for plugging filed \_\_\_\_\_ 19\_\_\_\_  
Application for plugging approved \_\_\_\_\_ 19\_\_\_\_  
Plugging commenced 3-9-66 \_\_\_\_\_ 19\_\_\_\_  
Plugging completed 3-13-66 \_\_\_\_\_ 19\_\_\_\_  
Reason for abandonment of well or producing formation \_\_\_\_\_  
Dry

If a producing well is abandoned, date of last production \_\_\_\_\_ 19\_\_\_\_  
Was permission obtained from the Conservation Division or its agents before plugging was commenced? Yes

Name of Conservation Agent who supervised plugging of this well Archie V. Elving

Producing formation \_\_\_\_\_ Depth to top \_\_\_\_\_ Bottom \_\_\_\_\_ Total Depth of Well 5170 Feet

Show depth and thickness of all water, oil and gas formations.

OIL, GAS OR WATER RECORDS

CASING RECORD

FORMATION	CONTENT	FRDM	TD	SIZE	PUT IN	PULLED OUT
				8 5/8	629	None
				5 1/2	None	3216

Describe in detail the manner in which the well was plugged, indicating where the mud fluid was placed and the method or methods used in introducing it into the hole. If cement or other plugs were used, state the character of same and depth placed, from \_\_\_\_\_ feet to \_\_\_\_\_ feet for each plug set.

Moved in. Cleaned out cellar. Sanded to 5075'. Dumped 5 sacks of cement.

Working pipe. Shot pipe at 4200' - 4100' - 4000' - 3900' & 3800'. Mud came in to 3000'. Run tubing. Spudding.

Pumping out mud bridge. Circulating. Working pipe.

Working pipe. Shot pipe at 3700' - 3600' - 3500' - 3400' - 3300' & 3200'. Pulling pipe.

Pulling pipe. Plugging well. Bailed to 300' rock bridge. Dumped 25 sacks. Filled hole and rock bridge. Capped well with 10 sacks of cement.

RECEIVED  
STATE CORPORATION COMMISSION

MAR 16 1966

(If additional description is necessary, use BACK of this sheet)

Name of Plugging Contractor Forbes Casing Pulling, Inc.  
Address P. O. Box 221 Great Bend, Kansas

STATE OF Kansas, COUNTY OF Barton, ss.

J. O. Forbes (employee of owner) or (owner or operator) of the above-described well, being first duly sworn on oath, says: That I have knowledge of the facts, statements, and matters herein contained and the log of the above-described well as filed and that the same are true and correct. So help me God.

(Signature) J. O. Forbes  
P. O. Box 221 Great Bend, Kansas  
(Address)

SUBSCRIBED AND SWORN TO before me this 15 day of March, 1966

My commission expires May 27, 1969

Notary Public.

Sunray DX Oil Company  
Wichita, Kansas

January 1966  
Wichita, Kansas

Drlg. Contractor: Stickle Drlg. Company  
Date Commenced : 15 December 1965  
Date Completed : 31 December 1965

A. B. Sidner No. 1  
17-29S-19W  
Kiowa County, Kansas


DRILLER'S LOG

Depth figures indicate base of formation:

Sand and shale	130
Sand	280
Shale and shells	480
Sand and shale	630
Shale and red bed	700
Red bed	1490
Anhydrite	1520
Shale and red bed	1550
Red bed and shale	2042
Shale w/lime streaks	2292
Shale and shells	2676
Shale and lime	2890
Lime and shale	3233
Shale and chalk	3500
Shale	3630
Shale w/lime streaks	3850
Lime and shale	3963
Lime	4340
Shale and lime	4510
Lime	5170 TD

RECEIVED  
STATE CORPORATION COMMISSION  
JAN 17 1966  
CONSERVATION DIVISION  
Wichita, Kansas

I, Clifford M. Smith, hereby certify that to the best of my knowledge and belief, the above is a true and complete Driller's Log of the Sunray A. B. Sidner No. 1, 17-29S-19W, Kiowa County, Kansas.

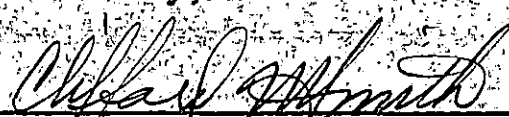  
Clifford M. Smith

Wanda J. Steakley  
My Commission Expires 16 January 1966