


STATE OF KANSAS
STATE CORPORATION COMMISSION

Form CP-4

WELL PLUGGING RECORD

Give All Information Completely
Make Required Affidavit
Mail or Deliver Report to:
Conservation Division
State Corporation Commission
212 No. Market
Wichita, Kansas 67202

NORTH

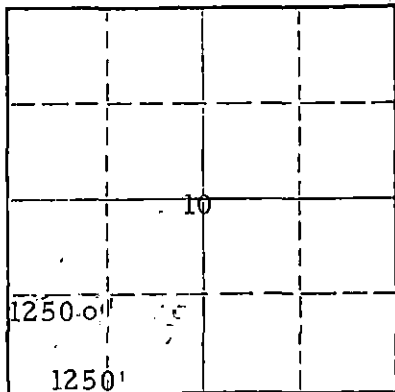

Locate well correctly on above
Section Plat

Stevens County, Sec. 10 Twp. 32S Rge. 39W(E) (W)
Location as "NE/CNW/SW" or footage from lines 1250 ft from S & W
Lease Owner Mesa Petroleum Co.
Lease Name Youngren Well No 2-10
Office Address Box 2009, Amarillo, Texas 79105
Character of Well (completed as Oil, Gas or Dry Hole) see remarks below *
Date well completed 10-27- 19 71
Application for plugging filed 10-7-71 19
Application for plugging approved 10-27- 19 71
Plugging commenced 10-28- 19 71
Plugging completed 10-28- 19 71

* Reason for abandonment of well or producing formation stuck pipe - could not recover fish economically

If a producing well is abandoned, date of last production none 19
Was permission obtained from the Conservation Division or its agents before plugging was commenced? Yes

Name of Conservation Agent who supervised plugging of this well Edgar J. Eves, Sublette, Kansas
Producing formation ----- Depth to top ----- Bottom ----- Total Depth of Well 2546 Feet
Show depth and thickness of all water, oil and gas formations.

OIL, GAS OR WATER RECORDS

CASING RECORD

FORMATION	CONTENT	FROM	TO	SIZE	PUT IN	PULLED OUT
Plug No.	Sacks	Depth				
1	50	1362-1225				
2	35	575-475				
3	15	45-GL				

All plugs separated with 9.1# drlg. mud, cut off 8 5/8" casing below GL 3'

Describe in detail the manner in which the well was plugged, indicating where the mud fluid was placed and the method or methods used in introducing it into the hole. If cement or other plugs were used, state the character of same and depth placed, from _____ feet to _____ feet for each plug set.

RECEIVED
STATE CORPORATION COMMISSION
NOV 3 1971
CONSERVATION DIVISION
Wichita, Kansas
11-3-71

(If additional description is necessary, use BACK of this sheet)

Name of Plugging Contractor Mesa, Garvey, and Halliburton
Address Mesa: Box 2009, Amarillo, Texas; Garvey Box 1164 Wichita, Ks; Halliburton, Liberal, Ks.

STATE OF Texas, COUNTY OF Potter, ss.
J. L. Farrell, Oper. Supt. (employee of owner) or (owner or operator) of the above-described

well, being first duly sworn on oath, says: That I have knowledge of the facts, statements, and matters herein contained and the log of the above-described well as filed and that the same are true and correct. So help me God.

(Signature) J. L. Farrell
Box 2009, Amarillo, Texas 79105 (Address)

SUBSCRIBED AND SWORN TO before me this 1st day of November, 19 71

My Commission Expires 6/1/73
William Main Notary Public


WELL LOG

COMPANY **Mesa Petroleum Company**
 FARM **Youngren** NO. **2-10**
 TOTAL DEPTH **2546'**
 COMM. **10-18-71** COMP. **10-27-71**
 CONTRACTOR **Garvey Drilling Company**

SEC. **10** T. **32S** R. **39W**

LOC. **NE SW SW**

COUNTY **Stevens, Kansas**

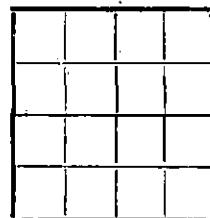

CASING
8 5/8" @ 594.60 w/500ex

ELEVATION

PRODUCTION **D & A**

FIGURES INDICATE BOTTOM OF FORMATIONS

- 195' Clay & Shale
- 550' Blue Shale & Sand
- 595' Red Bed
- 975' Red Bed & Shale
- 1275' Shale
- 1455' Sand
- 1481' Lime
- 1770' Shale & Lime
- 2315' Lime w/Shale
- 2546' Lime & Shale
- 2546' RTD

RECEIVED
 STATE CORPORATION COMMISSION
 NOV 9 1971
 CONSERVATION DIVISION
 Wichita, Kansas
 11-9-71

State of Kansas }
 County of Barton } SS

I, Charlene Marker of Garvey Drilling Company

upon oath state the above and foregoing is a true and correct copy of the log of the Youngren 2-10 well.

Subscribed and sworn to before me this 28th day of October 1971

My Commission Expires: July 8, 1974

Charlene Marker
James R. Morris
 NOTARY PUBLIC