


STATE OF KANSAS
STATE CORPORATION COMMISSION

Give information Completely
Make required Affidavit
Mail or Deliver Report to:
Conservation Division
State Corporation Commission
212 North Market, Insurance Bldg.
Wichita, Kansas

WELL PLUGGING RECORD

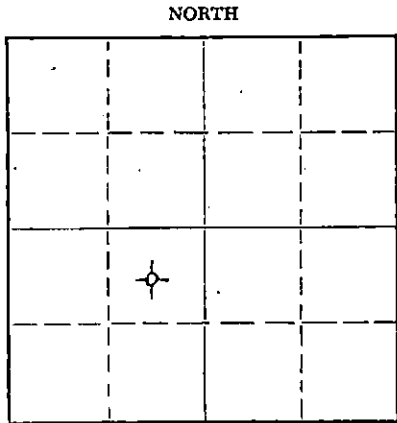

Locate well correctly on above
Section Plat

Kingman County, Sec. 26 Twp. 29S Rge. (E) 6 (W)
Location as "NE/CNW/SW" or footage from lines C NE SW
Lease Owner Lario Oil & Gas Company
Lease Name Alfred Tomm Well No. 1
Office Address 301 S. Market, Wichita, Kansas 67202
Character of Well (completed as Oil, Gas or Dry Hole) Dry Hole
Date well completed September 24, 19 67
Application for plugging filed September 24, 19 67
Application for plugging approved September 24, 19 67
Plugging commenced September 25, 19 67
Plugging completed September 25, 19 67
Reason for abandonment of well or producing formation Dry

If a producing well is abandoned, date of last production 19____
Was permission obtained from the Conservation Division or its agents before plugging was commenced? Yes

Name of Conservation Agent who supervised plugging of this well Archie V. Elving
Producing formation _____ Depth to top _____ Bottom _____ Total Depth of Well 4538 Feet
Show depth and thickness of all water, oil and gas formations.

OIL, GAS OR WATER RECORDS

CASING RECORD

FORMATION	CONTENT	FROM	TO	SIZE	PUT IN	PULLED OUT
				8 5/8"	300'	None

Describe in detail the manner in which the well was plugged, indicating where the mud fluid was placed and the method or methods used in introducing it into the hole. If cement or other plugs were used, state the character of same and depth placed, from _____ feet to _____ feet for each plug set.

Heavy mud to 250'. Set plug and spotted 1/2 sack cotton seed hulls and 25 sacks cement from 250' to 175'. Heavy mud to 35'. Set plug and spotted 1/2 sack hulls and 5 sacks cement to top of 8 5/8" casing. 4 sacks cement in rat hole.

RECEIVED
STATE CORPORATION COMMISSION
SEP 26 1967
9-26-67
CONSERVATION DIVISION
Wichita, Kansas

(If additional description is necessary, use BACK of this sheet)

Name of Plugging Contractor Gabbert-Jones
Address 830 Sutton Place, Wichita, Kansas

STATE OF Kansas, COUNTY OF Sedgwick, ss.
M. F. Kraft (employee of owner) or (owner/operator) of the above-described well, being first duly sworn on oath, says: That I have knowledge of the facts, statements, and matters herein contained and the log of the above-described well as filed and that the same are true and correct. So help me God.

(Signature) *M. F. Kraft*
301 S. Market, Wichita, Kansas 67202
(Address)

SUBSCRIBED AND SWORN TO before me this 26th day of September, 19 67

My commission expires July 21, 1970 *Frances Leslie* Notary Public.



LARIO OIL & GAS COMPANY
 No. 1 Alfred Tonn
 C NE SW Sec. 26-29S-6W
 Kingman County, Kansas

Drilling Commenced: 9-11-67
 Drilling Completed: 9-25-67
 Drilling Contractor: Gabbert-Jones, Inc.
 Total Depth - 4538'
 D. & A.

Casing Record:

8 5/8" 290' (T.O.) Set @ 300'
 Cem. w/ 225 sacks

Formation	Depth	Geological Tops - Elec. Log	
Clay, shale, sand & red rock	80	Base Wellington	1164' (+ 359)
Red bed	310	Herrington	1215' (+ 308)
Shale & shells	1010	Winfield	1282' (+ 241)
Lime & shale	1285	Towanda	1354' (+ 169)
Lime	1455	Fort Riley	1405' (+ 118)
Lime & shale	3190	Florence	1447' (+ 76)
Lime & shale, sandy shale	3275	Wabaunsee	2085' (- 562)
Lime	3355	Howard	2517' (- 994)
Lime & shale	3563	Topeka	2658' (-1135)
Lime	3770	Heebner	3019' (-1496)
Lime & shale	3900	Douglas	3057' (-1534)
Lime	3950	Douglas Sand	3066-76'
Lime & shale	4132	Lansing	3254' (-1731)
Mississippi lime	4330	Kansas City	3522' (-1999)
Lime & chert	4405	Base Kansas City	3790' (-2267)
Lime	4450	Marmaton	3839' (-2316)
Lime & shale	4493	Cherokee	3958' (-2435)
Viola lime	4514	Eros. Mississippian	4116' (-2593)
Simpson sand	4521	Mississippian Lime	4128' (-2605)
Sand	4538	Mississippian Chert	4136' (-2613)
		Kinderhook	4380' (-2857)
		Misener	4474' (-2951)
		Maquoketa	4477' (-2954)
		Viola	4491' (-2968)
		Simpson Shale	4504' (-2981)
		Simpson Dolomite	4508' (-2985)
		Simpson Sand	4513' (-2990)
		Log Total Depth	4540' (-3017)

RECEIVED

CONSERVATION COMMISSION

SEP 26 1967

9-26-67

CONSERVATION DIVISION
Wichita, Kansas