

STATE OF KANSAS
STATE CORPORATION COMMISSION

Give All Information Completely
Make Required Affidavit
Mail or Deliver Report to:
Conservation Division
State Corporation Commission
212 North Market, Insurance Bldg.
Wichita, Kansas

WELL PLUGGING RECORD

Kingman

County, Sec. 27 Twp. 29 Rge. (E) 6W(W)

Location as "NE/CNWxSWx" or footage from lines Gen. SW SW

Lease Owner Lario Oil & Gas Company

Lease Name Ruth Well No. 1

Office Address 301 S. Market, Wichita 2, Kansas

Character of Well (completed as Oil, Gas or Dry Hole) Dry Hole

Date well completed 7-20- 19 61

Application for plugging filed 7-20- 19 61

Application for plugging approved 7-20- 19 61


Plugging commenced 7-20- 19 61

Plugging completed 7-21- 19 61

Reason for abandonment of well or producing formation Dry hole

If a producing well is abandoned, date of last production 19

Was permission obtained from the Conservation Division or its agents before plugging was commenced? Yes

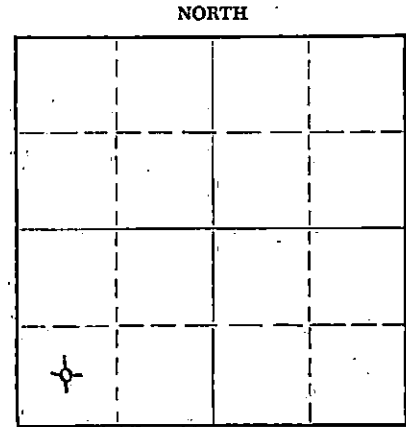

Locate well correctly on above Section Plat

Name of Conservation Agent who supervised plugging of this well Fred Hampel

Producing formation Depth to top Bottom Total Depth of Well 4570 Feet

Show depth and thickness of all water, oil and gas formations.

OIL, GAS OR WATER RECORDS

CASING RECORD

FORMATION	CONTENT	FROM	TO	SIZE	PUT IN	PULLED OUT
				8 5/8"	280 Set at	293.66' Cem. 225 sacks

Describe in detail the manner in which the well was plugged, indicating where the mud fluid was placed and the method or methods used in introducing it into the hole. If cement or other plugs were used, state the character of same and depth placed, from feet to feet for each plug set.

Heavy mud from T.D. to 240'. Set plug at 240', 1/4 sack hulls, 20 sacks cement.
Mud to 35'. Set plug at 35', 1/4 sack hulls, 10 sacks cement to base of cellar.
2 sacks cement in rat hole.

RECEIVED
STATE CORPORATION COMMISSION
7-27-61
JUL 27 1961

CONSERVATION DIVISION
Wichita, Kansas

(If additional description is necessary, use BACK of this sheet)

Name of Plugging Contractor Prime Drilling Co.

Address Wichita, Kansas

STATE OF Kansas, COUNTY OF Sedgwick, ss.

Leo Ross (employee of owner) or (owner/operator) of the above-described

well, being first duly sworn on oath, says: That I have knowledge of the facts, statements, and matters herein contained and the log of the above-described well as filed and that the same are true and correct. So help me God.

(Signature) *Leo Ross*

301 S. Market, Wichita, Kansas

(Address)

SUBSCRIBED AND SWORN TO before me this 25th day of July 19 61

Frances Leslie

Notary Public.

My commission expires July 21, 1962



LARIO OIL & GAS COMPANY
Ruth No. 1
Gen. SW SW Sec. 27-29S-6W
Kingman County, Kansas

Drilling Commenced: July 3, 1961
Drilling Completed: July 20, 1961
Well Plugged: July 21, 1961
Drilling Contractor: Prime Drilling Company
Total Depth 4570'
I.P. - Dry & Abandoned

RECEIVED
STATE CORPORATION COMMISSION
7-27-61
JUL 27 1961
CONSERVATION DIVISION
Wichita, Kansas

CASING RECORD:
8 5/8" 280' Set @ 293.66'
Cem. w/ 225 sacks

Formation	Depth
Sand	38
Red bed	272
Red bed & shale	1100
Shale & shells	1180
Lime	1554
Lime & shale	3087
Lime	3107
Sand	3119
Shale & lime	3305
Lime	3776
Lime & shale	3865
Lime	4160
Mississippi lime	4290
Lime	4378
Chert & lime	4400
Lime	4434
Lime & shale	4457
Shale	4502
Sand & shale	4512
Lime	4549
Sand	4570

GEOLOGICAL TOPS - Elec. Log - K.B. Meas.

Elevation	
1527	R.B.
1525	D.F.
3063	(-1536) Heebner
3094	(-1567) Douglas
3307	(-1780) Lansing
3559	(-2032) Kansas City
3992	(-2465) Cherokee
4154	(-2627) Mississippian
4404	(-2877) Kinderhook
4499	(-2972) Misener
4518	(-2991) Viola
4538	(-3011) Simpson Dolomite
4549	(-3022) Simpson Sand
4570	(-3043) R.T.D.
4573	(-3046) Sch. T.D.

I hereby certify that this is a true and correct log of the above mentioned well.

[Signature]

STATE OF KANSAS)
COUNTY OF SEDGWICK) SS

Subscribed and sworn to before me, a notary public, in and for said County and State this 26th day of July, 1961.

[Signature]
Notary Public

My Commission expires July 21, 1962

