


STATE OF KANSAS
STATE CORPORATION COMMISSION

WELL PLUGGING RECORD

Give All Information Completely
Make Required Affidavit
Mail or Deliver Report to
Conservation Division
State Corporation Comm.
245 North Water
Wichita, KS 67202

Kingmen County. Sec. 27 Twp. 29S Rge. 6W E/W
Location as "NE/CNW $\frac{1}{4}$ SW $\frac{1}{4}$ " or footage from lines
4 1/2 - NW - SW

Lease Owner Pickrell Drilling Co.
Lease Name Ruth Well No. A-1
Office Address 205 Litwin Bldg., 110 N. Market, Wichita, Ks. 67202
Character of Well (Completed as Oil, Gas or Dry Hole)

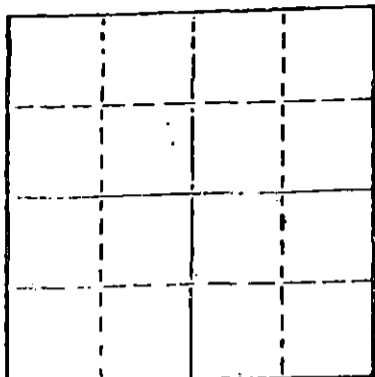

Locate well correctly on above
Section Plat

Oil
Date Well completed 9-25 19 81
Application for plugging filed 10-20 19 81
Application for plugging approved 11-5 19 81
Plugging commenced 11-7 19 81
Plugging completed 11-23 19 81
Reason for abandonment of well or producing formation

Not Productive
If a producing well is abandoned, date of last production 19

Was permission obtained from the Conservation Division or
its agents before plugging was commenced? Yes

Name of Conservation Agent who supervised plugging of this well M. V. Leslie
Producing formation _____ Depth to top _____ Bottom _____ Total Depth of Well 4531
Show depth and thickness of all water, oil and gas formations.

OIL, GAS OR WATER RECORDS

CASING RECORD

FORMATION	CONTENT	FROM	TO	SIZE	PUT IN	PULLED OUT
				8 5/8	208	None
				4 1/2	4272	3120

Describe in detail the manner in which the well was plugged, indicating where the mud fluid
was placed and the method or methods used in introducing it into the hold. If cement or other
plugs were used, state the character of same and depth placed, from _____ feet to
_____ feet for each plug set.

RECEIVED
STATE CORPORATION COMMISSION

Sand from 4237 to 4100
4 sacks cement 4100 to 4068

DEC - 1 1981

Ripped at 3700 3580 3460 3340 3120

CONSERVATION DIVISION
Wichita, Kansas

Allied pump in 15 sacks gel - 6 sacks hull 10 sacks gel

125 sacks common cement 2% gel 3% c.c.

RECEIVED
STATE CORPORATION COMMISSION
DEC - 1 1981

12-1-81

(If additional description is necessary, use BACK of this sheet)

Name of Plugging Contractor Clarke Corporation

CONSERVATION DIVISION
Wichita, Kansas

STATE OF Kansas COUNTY OF Barber, ss.
Elmer R. Margenstern (employee of owner) or (owner or operator)
of the above-described well, being first duly sworn on oath, says: That I have knowledge of
the facts, statements, and matters herein contained and the log of the above-described well
as filed and that the same are true and correct. So help me God.

(Signature) Elmer R. Margenstern
Medicine Lodge, Ks.
(Address)

SUBSCRIBED AND SWORN TO before me this 28th day of November, 1981

Jessie Hamerton
Notary Public.


My commission expires April 4, 1982.

15-095-21154-0000

BAKER OIL TOOLS, INC.

SERVING THE WORLD

DATE 10-19-81 WELL NO. 1 LEASE Ruth "A" FIELD Rosedale

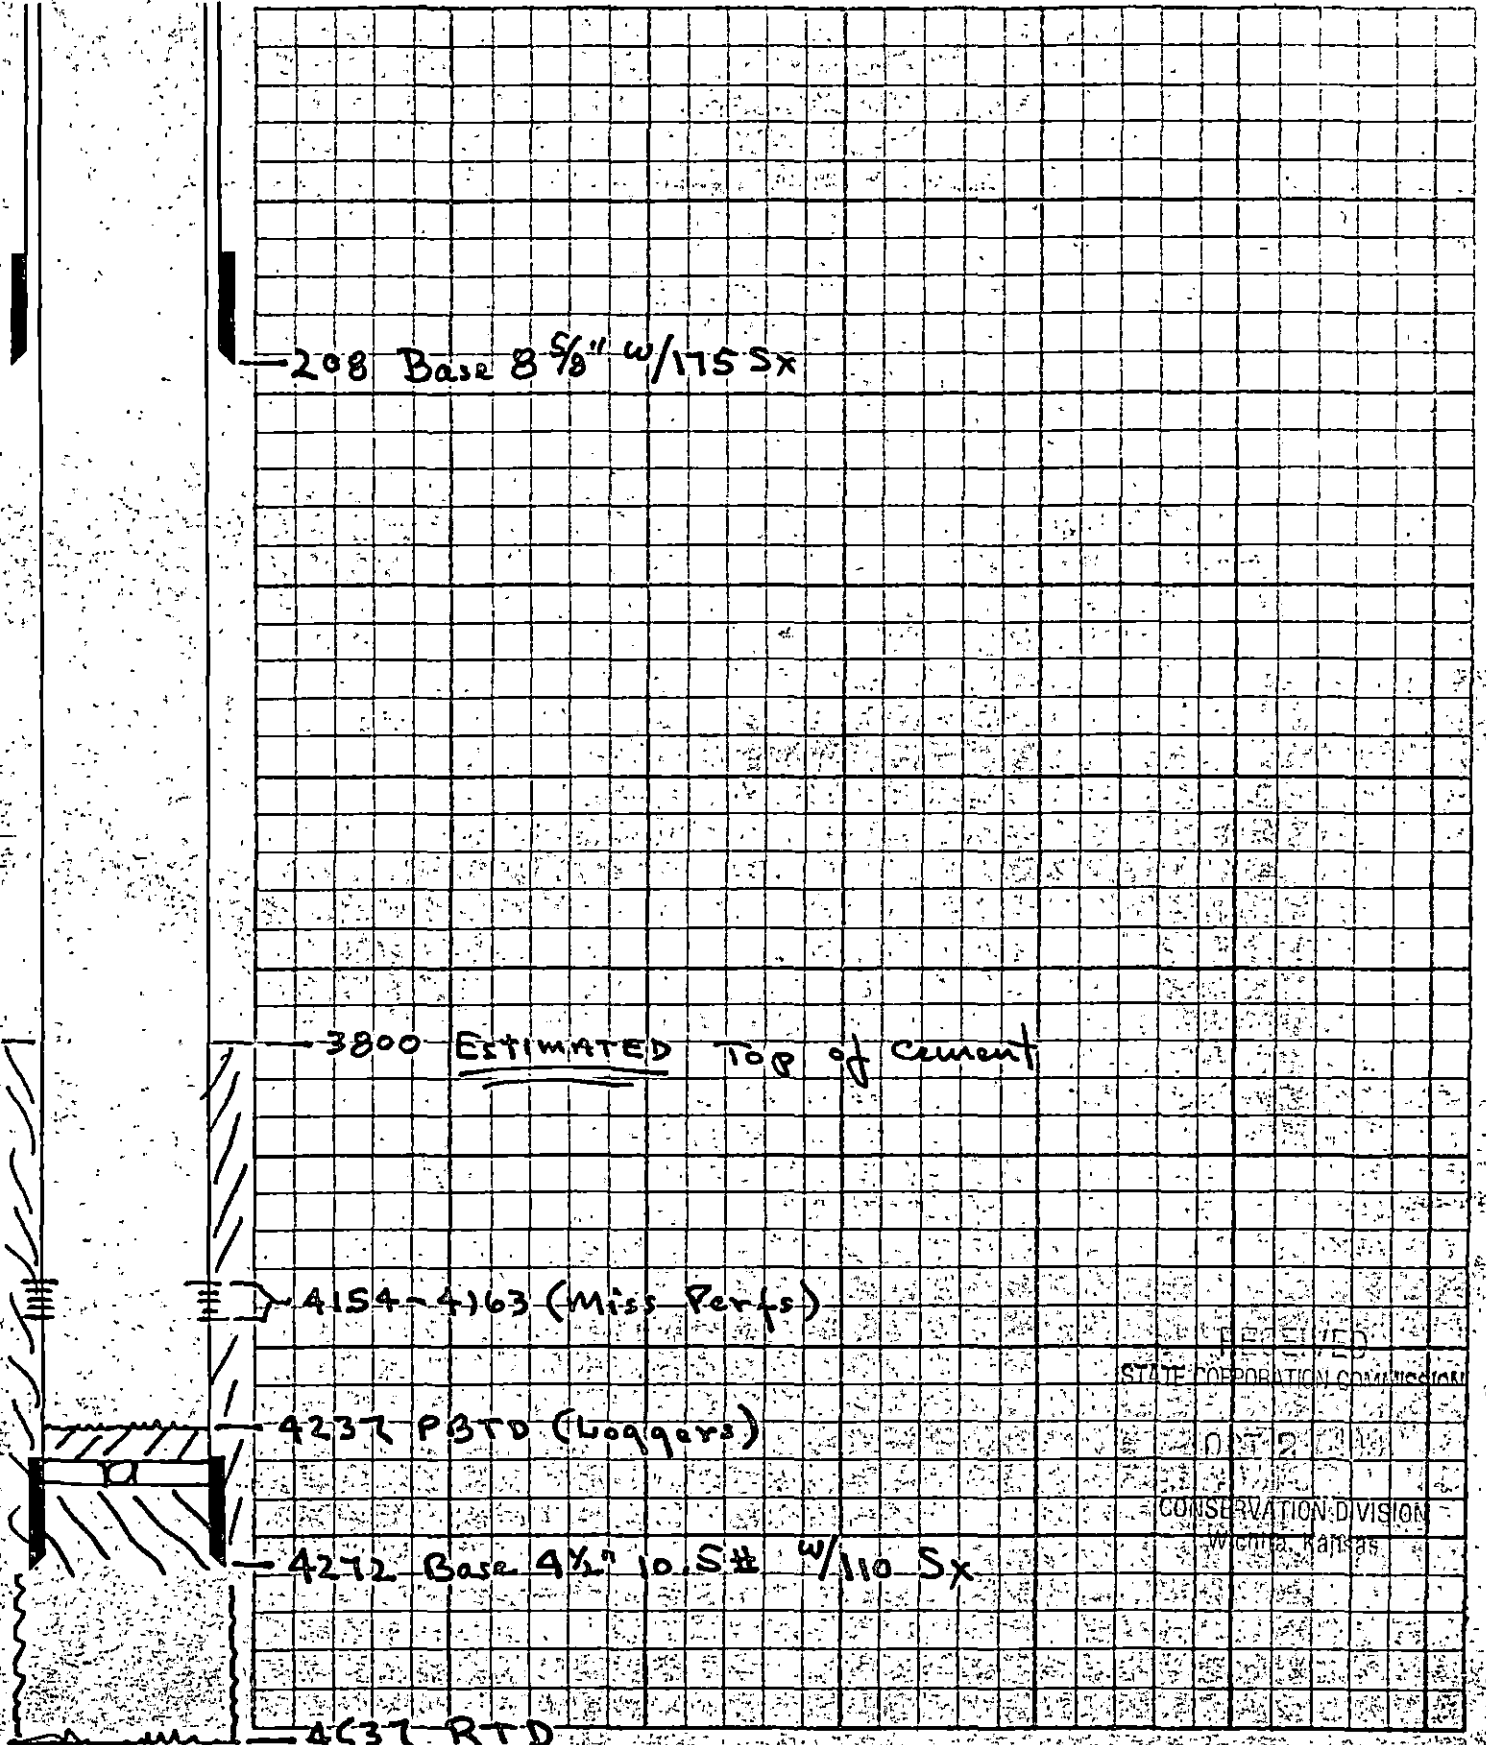

 BRIDGE PLUG
  PACKER
  CENTRALIZER
  SCRATCHER
  BASKET
  PERFORATION

(Use reverse side for additional remarks & sketches.)

ROTARY DRILLING LOG

COMPANY: Pickrell Drilling Company
 205 Litwin Building, 110 North Market
 Wichita, Kansas 67202
 LOCATION: #1 Ruth 'A'
 W/2 NW SW, Sec. 27-29S-6W
 Kingman County, Kansas
 CONTRACTOR: **PICKRELL DRILLING COMPANY**
 Wichita, Kansas
 CASING RECORD: Surface pipe-8 5/8" at 208' w/175 sx.
 Production csg-4 1/2" at 4272' w/110 sx.

Rotary Drilling Commenced 9-14-81
 Rotary Drilling Completed 9-25-81

LOG

(Figures indicate bottom of formation — measurements from top of rotary bushing.)

Top Soil & Sand	10
Redrock	217
Red Bed & Shale	750
Shale	1365
Shale & Lime	2025
Lime & Shale	2270
Shale & Lime	2500
Lime & Shale	2990
Shale & Lime	3245
Lime & Shale	3522
Shale & Lime	3645
Lime & Shale	3716
Shale	3750
Lime & Shale	3793
Lime	4023
Lime & Shale	4143
Shale	4165
Shale & Lime	4307
Lime	4537

RECEIVED
 STATE CORPORATION COMMISSION
 10-21-81
 OCT 21 1981
 CONSERVATION DIVISION
 Wichita, Kansas

The undersigned, David H. Tripp, Attorney-in-Fact for PICKRELL DRILLING COMPANY, hereby certifies in behalf of said Company, that the above is a true and correct log of the formation encountered in drilling the above well as reflected by the Daily Drilling Reports.

PICKRELL DRILLING COMPANY

By David H. Tripp
 Attorney-in-Fact
 David H. Tripp

STATE OF KANSAS }
 COUNTY OF SEDGWICK } ss.:

On this 20th day of October, 1981, before me the undersigned, a Notary Public, in and for the County and State aforesaid, personally appeared David H. Tripp, to me known to be the identical person who subscribed the name of PICKRELL DRILLING COMPANY to the foregoing instrument as its Attorney-in-Fact and acknowledged to me that he executed the same as his free and voluntary act and deed, and as the free and voluntary act and deed of such company, for the uses and purposes therein set forth.

Given under my hand and seal of office the day and year last above written.

My commission expires: December 31, 1982
 STATE NOTARY PUBLIC
 Sedgwick County, Kansas

Jana Lea Schneewis
 Notary Public
 Jana Lea Schneewis