


STATE OF KANSAS
CORPORATION COMMISSION

WELL PLUGGING RECORD

All Information Completely
Required Affidavit
or Deliver Report to
Conservation Division
State Corporation Comm.
245 North Water
Wichita, KS 67202

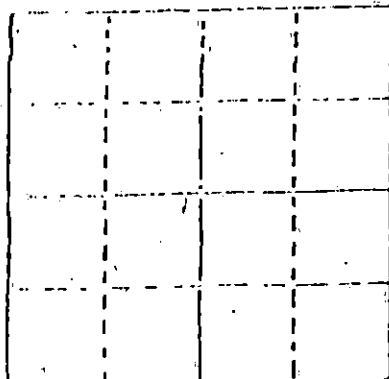

Locate well correctly on above
Section Plat

Greenwood County, Sec. 29 Twp. 23 Rge. 11E E&W
Location as "NE/CNW/SW" or footage from lines
NE NE NW
Lease Owner Lucky Strike Exploration, Inc.
Lease Name Edwards Well No. 1
Office Address P.O. Box 278, Potwin, KS 67123
Character of Well (Completed as Oil, Gas or Dry Hole)

Dry

Date Well completed 6/27/82
Application for plugging filed 6/27/82
Application for plugging approved 6/27/82
Plugging commenced 6/27/82
Plugging completed 6/27/82
Reason for abandonment of well or producing formation

If a producing well is abandoned, date of last production 19

Was permission obtained from the Conservation Division or
its agents before plugging was commenced? Yes

of Conservation Agent who supervised plugging of this well David Monacle
cing formation Depth to top Bottom Total Depth of Well 2050'
depth and thickness of all water, oil and gas formations.

GAS OR WATER RECORDS

CASING RECORD

LOCATION	CONTENT	FROM	TO	SIZE	PUT IN	PULLED OUT
	Surface	0	106.45	85/8"	106.45'	0

Describe in detail the manner in which the well was plugged, indicating where the plug
placed and the method or methods used in introducing it into the hole. If cement or
other materials were used, state the character of same and depth placed, from feet
feet for each plug set.

Mud @ 210' 1/2 sack hulls plug
25 Sacks cement @ 50' 1/2 hulls plug
fill to top
4 Sacks in rathole

(If additional description is necessary, use BACK of this sheet)

Plugging Contractor EDCO Drilling Company, Inc.

of Kansas COUNTY OF Butler, ss.

(employee of owner) or (owner or
above-described well, being first duly sworn on oath, says: That I have known
its, state its, and matters herein contained and the log of the above-described
and that the same are true and correct. So help me God.

(Signature)

A.C. Teichgraber
Box 645, El Dorado, Kansas 67042
(Address)

SWORN AND SWORN TO before me this 11 day of 1982

Notary Public

RECEIVED
STATE CORPORATION COMMISSION

NOV 9 1983

11-9-83

WICHITA, KANSAS

STATE OF KANSAS
STATE CORPORATION COMMISSION
CONSERVATION DIVISION
P. O. BOX 17027
WICHITA, KANSAS 67217

Rev. 6-3-74
FORM CP-1

WELL PLUGGING APPLICATION FORM
File One Copy

PI Number 15 - 073 - 22,353 (of this well)
Case Owner Lucky Strike Exploration, Inc.
Address P.O. Box 278, Potwin, Kansas 67123
Case (Farm Name) Edwards Well No. 1
Well Location Sec. 29 Twp. 23 Rge. 11 (E) X (W)
County Greenwood Total Depth 2050' Field Name _____
Oil Well _____ Gas Well _____ Input Well _____ SWD Well _____ Rotary D & A _____
Well Log attached with this application as required Yes
Date and hour plugging is desired to begin 6-27-82

PLUGGING OF THIS WELL WILL BE DONE IN ACCORDANCE WITH K.S.A. 55-128 OF THE RULES AND REGULATIONS OF THE STATE CORPORATION COMMISSION.

Name of company representative authorized to be in charge of plugging operations:

A.C. Teichgraeber Address Box 645, El Dorado, Kansas

Plugging Contractor EDCO Drilling Company, Inc. License No. _____

Address 124 West Locust, El Dorado, Kansas 67042

Invoice covering assessment for plugging this well should be sent to:

Name Lucky Strike Exploration, Inc.

Address P.O. Box 278, Potwin, Kansas 67123

and payment will be guaranteed by applicant or acting agent.

RECEIVED
STATE CORPORATION COMMISSION

NOV 9 1983
11-9-83
CONSERVATION DIVISION
Wichita, Kansas

Signed: A.C. Teichgraeber
Applicant or Acting Agent

Date: June 30, 1982