

WELL PLUGGING RECORD

Give All Information Completely  
Make Required Affidavit  
Mail or Deliver Report to:  
Conservation Division  
State Corporation Commission  
800 Bittling Building  
Wichita, Kansas

Harper

County. Sec. 9 Twp. 35S Rge. (E) 5 (W)

Location as "NE/CNW/SW" or footage from lines NW NW SE; 440'NL & 440'WL

Lease Owner Shell Oil Company

Lease Name C. D. WILLIAMS Well No. 1

Office Address P. O. Box 744, Great Bend, Kansas

Character of Well (completed as Oil, Gas or Dry Hole) Dry Hole

Date well completed April 6 19 59

Application for plugging filed April 9 19 59

Application for plugging approved (verbal) April 8 19 59


Plugging commenced April 8 19 59

Plugging completed April 8 19 59

Reason for abandonment of well or producing formation Dry Hole

If a producing well is abandoned, date of last production 19

Was permission obtained from the Conservation Division or its agents before plugging was commenced? Yes

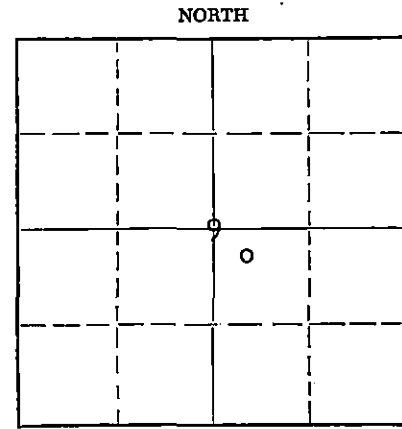

Locate well correctly on above Section Plat

Name of Conservation Agent who supervised plugging of this well Fred Hampel

Producing formation Mississippian Depth to top 4604 Bottom - Total Depth of Well 4948 Feet

Show depth and thickness of all water, oil and gas formations.

OIL, GAS OR WATER RECORDS


CASING RECORD

| FORMATION     | CONTENT | FROM | TO   | SIZE   | PUT IN | PULLED OUT |
|---------------|---------|------|------|--------|--------|------------|
| Mississippian | Dry     | 4604 | 4948 | 9-5/8" | 283'   | None       |
|               |         |      |      |        |        |            |
|               |         |      |      |        |        |            |
|               |         |      |      |        |        |            |

Describe in detail the manner in which the well was plugged, indicating where the mud fluid was placed and the method or methods used in introducing it into the hole. If cement or other plugs were used, state the character of same and depth placed, from \_\_\_\_\_ feet to \_\_\_\_\_ feet for each plug set.

Filled hole with heavy rotary mud. Pushed 9-5/8" Halliburton plug to 280'. Capped plug with 35 sac common cement to 192'. Mudded hole to 40'. Pushed 9-5/8" Halliburton plug to 40'. Capped plug with 15 sac common cement to base of cellar. Cut casing head off of 9-5/8" casing & welded steel plate over 9-5/8" casing 5' below ground level.

Note: Rat hole plugged as recommended with mud & cement.

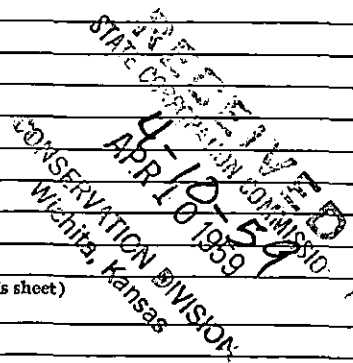

(If additional description is necessary, use BACK of this sheet)

Name of Plugging Contractor Garvey Drilling Company

Address Route 2, Great Bend, Kansas

STATE OF KANSAS, COUNTY OF BARTON, ss.

A. W. Weber (employee of owner) ~~owner or operator~~ of the above-described well, being first duly sworn on oath, says: That I have knowledge of the facts, statements, and matters herein contained and the log of the above-described well as filed and that the same are true and correct. So help me God.

(Signature) A. W. Weber

P. O. Box 744, Great Bend, Kansas  
(Address)

SUBSCRIBED AND SWORN TO before me this 9th day of April, 19 59

LaMont Byers, Jr.  
Notary Public.

My commission expires January 28, 1961

PLUGGING  
FILE SEC. 9 T. 35 R. 5W  
BOOK PAGE 29 LINE 19

SHELL-C. D. WILLIAMS #1  
NW NW SE Section 9-35S-5W  
Wildeat  
Harper County, Kansas

Casing Record

9-5/8" cem 283 with 200 sax plus 1/2# Flocele  
per sack; cement circulated.

- 0 - 247 red rock & shale
- 289 shale
- 1277 lime
- 1992 lime & shale
- 2247 shale & lime
- 2372 shale
- 2577 shale & lime
- 2771 lime & shale
- 2937 shale & lime
- 3477 lime & shale
- 3627 lime
- 3702 sand, lime & shale
- 3767 shale & lime
- 3794 sand, shale & lime
- 3957 shale
- 4059 lime
- 4294 lime & shale
- 4349 shale & lime
- 4382 shale & lime
- 4502 lime & shale
- 4608 shale & lime
- 4650 lime
- 4664 chert & lime
- 4715 shale & chert
- 4730 chert & lime
- 4754 lime & shale
- 4769 chert, shale & lime
- 4944 lime, cherty
- 4948 lime TD

Formation Tops:  
Stalnaker 3508  
Kansas City 3958  
Mississippian 4604

SHALE COUNTY  
 APR 10 1959  
 CONSERVATION DIVISION  
 Wichita, Kansas  
 4-10-59

|                 |         |      |      |
|-----------------|---------|------|------|
| <b>PLUGGING</b> |         |      |      |
| FILE            | SEC 9   | T 35 | R 5W |
| BOOK            | PAGE 29 | LINE | 11   |