15-191-20187-0000


STATE OF KANSAS
STATE CORPORATION COMMISSION

Form CP-4

Give All Information Completely
Make Required Affidavit
Mail or Deliver Report to:
Conservation Division
State Corporation Commission
212 No. Market
Wichita, Kansas 67202

WELL PLUGGING RECORD

NORTH

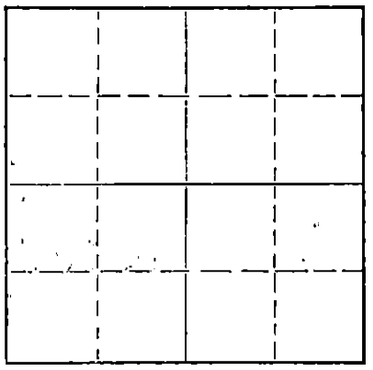

Locate well correctly on above Section Plat

Sumner County. Sec. 18 Twp. 35S Rge. 4W (E) (W)

Location as "NE/CNW¼SW¼" or footage from lines

Lease Owner Quintin Little

Lease Name Wolff Well No. 1

Office Address Box 1509, Ardmore, Okla. 73401

Character of Well (completed as Oil, Gas or Dry Hole) Dry hole

Date well completed March 13, 1970 19

Application for plugging filed March 13, 1970 19

Application for plugging approved March 13, 1970 19

Plugging commenced March 14, 1970 19

Plugging completed March 14, 1970 19

Reason for abandonment of well or producing formation

If a producing well is abandoned, date of last production 19

Was permission obtained from the Conservation Division or its agents before plugging was commenced? yes

Name of Conservation Agent who supervised plugging of this well Howard Hess

Producing formation Depth to top Bottom Total Depth of Well 5460 Feet

Show depth and thickness of all water, oil and gas formations.

OIL, CAS OR WATER RECORDS — CASING RECORD

FORMATION	CONTENT	FROM	TO	SIZE	PUT IN	PULLED OUT
Tonkawa Sand	Water	3540'	3768'	8-5/8"	259'	none
Layton Sand	Water	4020'	4040'			
Big Lime	Tight	4292'	4318'			
Mississippi Chert	Tight	4678'	4750'			
Mississippian	Tight	4750'	5112'			
Simpson	Water	5183'	5250'			
2nd Wilcox	Tight	5300'	5346'			
Arbuckle	Tight	5420'	5460'			

Describe in detail the manner in which the well was plugged, indicating where the mud fluid was placed and the method or methods used in introducing it into the hole. If cement or other plugs were used, state the character of same and depth placed, from feet to feet for each plug set.

Filled hole with heavy mud to 242 ft. Set plug at 242 ft. with 30 sacks cement.
Set plug at 40 ft. to surface with 8 sacks cement. Put two sacks in rat hole.
Job complete at 5:30 a.m. 3-14-70.

RECEIVED
STATE CORPORATION COMMISSION
MAR 23 1970
CONSERVATION DIVISION
Wichita, Kansas
3-23-70

(If additional description is necessary, use BACK of this sheet)

Name of Plugging Contractor Graves Drilling Company, Inc.

Address 501 Union Center, Wichita, Kansas 67202

STATE OF Oklahoma, COUNTY OF Carter, ss.

Glen D. Vanway (employee of owner) or (owner or operator) of the above-described well, being first duly sworn on oath, says: That I have knowledge of the facts, statements, and matters herein contained and the log of the above-described well as filed and that the same are true and correct. So help me God.

(Signature) Glen Vanway

Box 1509, Ardmore, Okla. 73401
(Address)

SUBSCRIBED AND SWORN TO before me this 19th day of March, 1970

Grace E. Kornhaas
Notary Public.

My commission expires 3-13-71

15-191-20187-0000

RECEIVED
STATE CORPORATION COMMISSION
MAR 17 1970
CONSERVATION DIVISION
Wichita, Kansas

3-17-70

ROTARY DRILLERS' LOG

OPERATOR: Quintin Little
Box 1509
Ardmore, Oklahoma

DRILLING COMMENCED: Feb. 26, 1970

CONTRACTOR: Graves Drilling Co., Inc.
505 Union Center
Wichita, Kansas

DRILLING COMPLETED: Mar. 14, 1970

CASING RECORD: 8 5/8" surface casing, set at 259', with 200 sacks of cement.

LOCATION: Wolf #1
SE/4 SE/4 SW/4 Sec. 18-35S-4W,
Sumner County, Kansas

0	-	21	Soil
21	-	228	Shale
228	-	267	Shale & shells
267	-	502	Red bed
502	-	1076	Shale & shells
1076	-	1160	Lime
1160	-	1470	Shale
1470	-	1727	Sandy lime
1727	-	2406	Shale & shells
2406	-	2890	Shale
2890	-	3207	Lime & shale
3207	-	3228	Shale
3228	-	3533	Shale & shells
3533	-	3665	Sandy Shale
3665	-	3990	Shale
3990	-	4151	Sandy lime
4151	-	4340	Lime
4340	-	4678	Shale & shells
4678	-	5142	Lime
5142	-	5185	Shale
5185	-	5258	Sand
5258	-	5258	Sandy Shale
5258	-	5260	Iron pyrite
5260	-	5388	Sand & shale
5388	-	5460	Lime

I hereby certify the foregoing statements to be true and correct, to the best of my knowledge.

GRAVES DRILLING COMPANY, INC.

By John C. Graves

STATE OF KANSAS)
SEDGWICK COUNTY)

Subscribed and sworn to before me, a Notary Public, on this 16th day of March, 1970.

My Commission Expires: July 27, 1971.

WILMA RILLER NOTARY PUBLIC SEDGWICK COUNTY, KANSAS


Wilma Riller
Wilma Riller, Notary Public

15-191-20187-0000

Gp 3-175 Map No

OPER QUINTIN LITTLE
BOX 1509, ARDMORE, OKLAHOMA
WELL #1 WOLFF
CONTR GRAVES DRLG CO., INC.
WC 5 MI SE/ABD BLUFF CREEK FIELD (LAN)
I.P. D&A
API #15-191-20187
PTD 5500

WELL CLASS
WF WF
INIT. FIN.

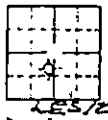

LES/2440F

S-T-R 18-35S-4W
SPOT APP SE NE SW
CO SUMNER, KS
ELEV. 1247 KB
1245 DF
1242 GR
3630' FNL
2310' FWL
330' FSL(STATE LINE)
OF IRREG SEC


SPUD 2-26-70 8 5/8" @ 258/200 SX GEOL: JIM HALLITT
NO CORES
DST 1 (SP) 5188-95, OP 1 HR, REC 55' SWTR, ISIP 2146/30 MIN, IFP 24, FFP 37, FSIP 2107/1 HR, HP 2566-2547
RTD 5468 DRESSER ATLAS LOG D&A COMPLETED 3-15-70


CORRECTION: SPOT WAS: SE SE SW IS: APP SE NE SW OF IRREG SECTION

KB LOG TOPS

CHASE	1657	- 410
ADM	2030	- 783
PENN SD	2200	- 953
TOP	2760	-1513
HB	3180	-1933
DG	3360	-2113
"STAL" Lm.	3528	-2281
YONKAWA (Stal.)	3560	-2313

over

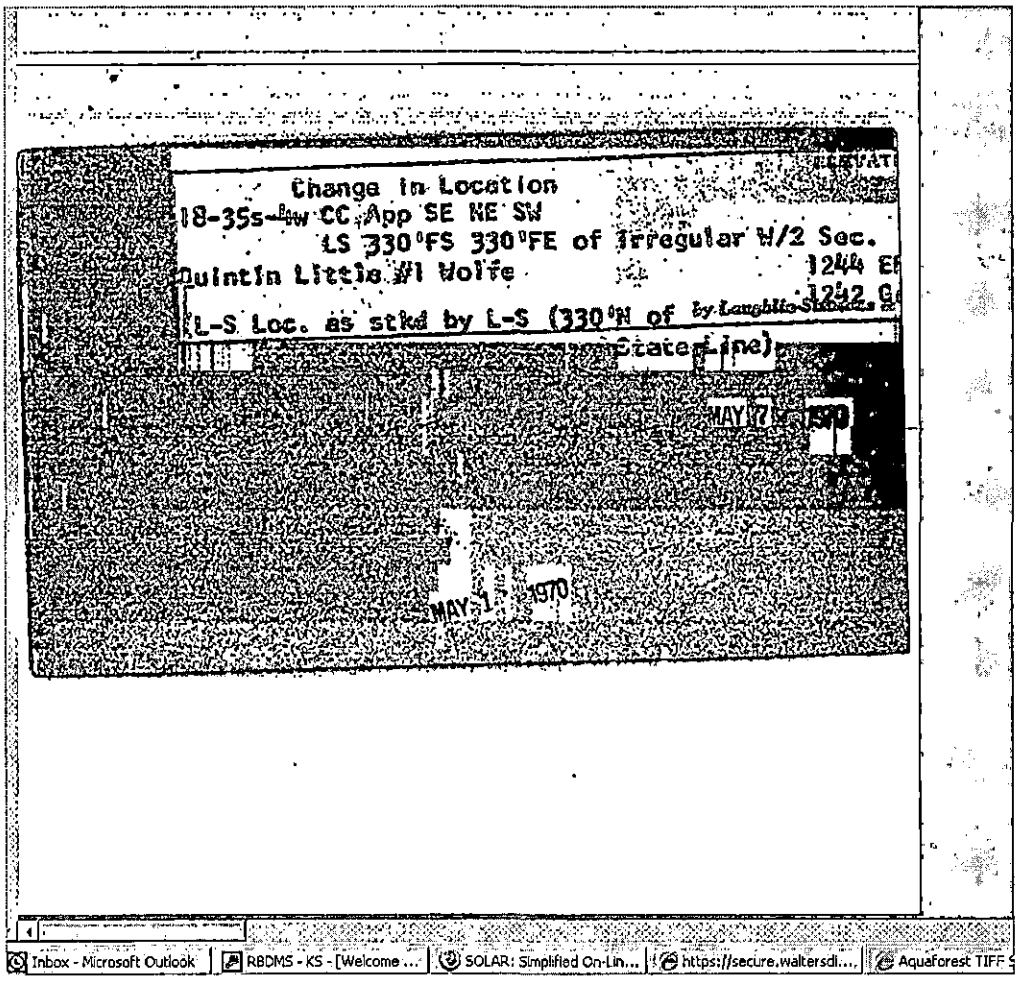
Change in Location
18-35s-[illegible]w CC App SE NE SW
LS 330'FS 330'FE of Irregular W/2 Sec.
Quintin Little #1 Wolfe
1244 E
1242 G
L-S Loc. as stkd by L-S (330'N of
by Langhlin
State Line)
MAY 7
1970
MAY
1970
Inbox - Microsoft Outlook
RBDMS - KS - [Welcome ...
SOLAR: Simplified On-Lin...
https://secure.waltersdi...
AquaForest TIFF

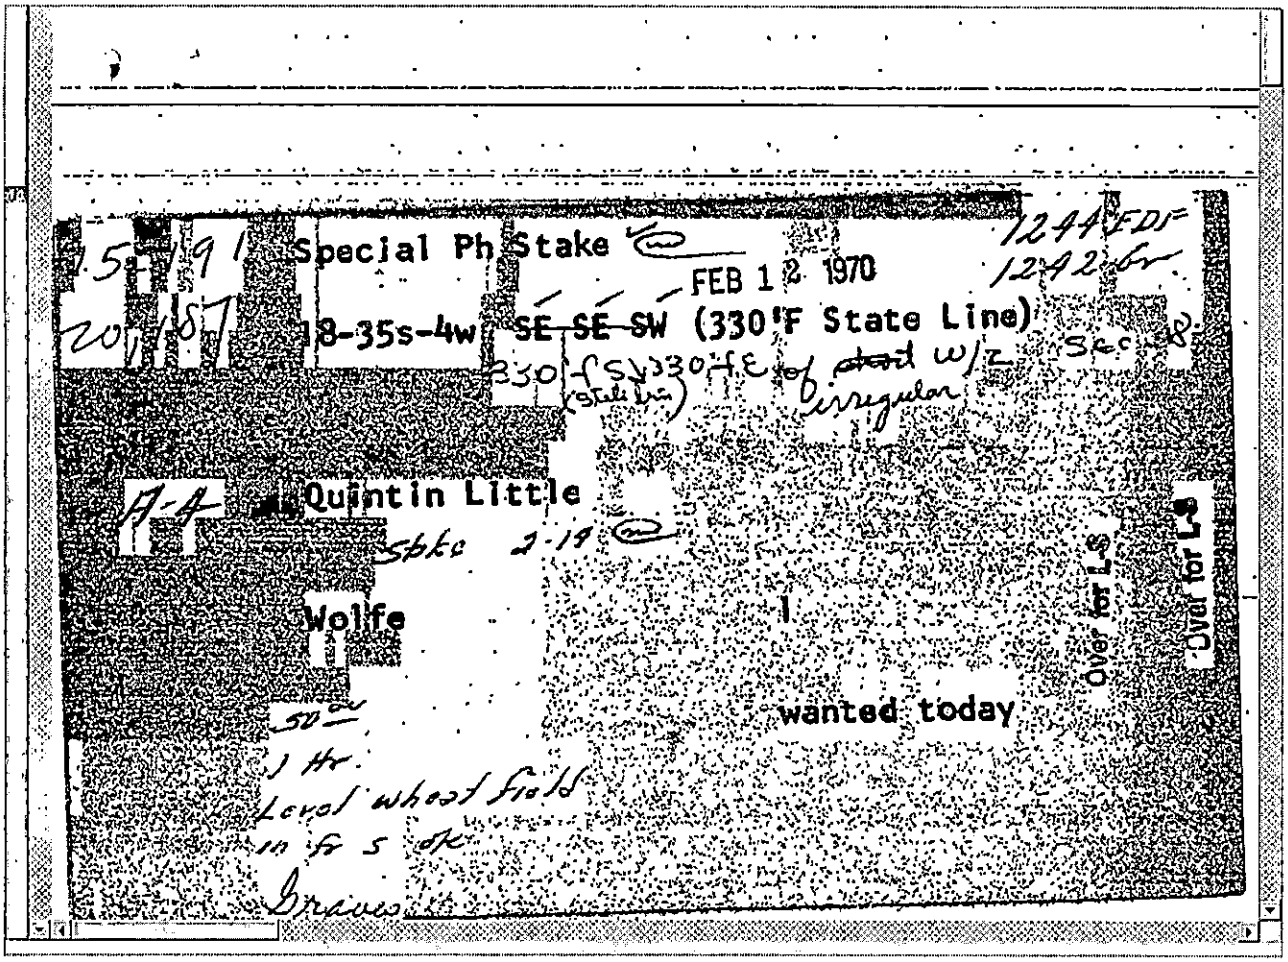
Special Ph Stake
FEB 12 1970
SE SE SW (330' F State Line)
Quintin Little
Wolfe
wanted today
Over for L's
Over for L's