


STATE OF KANSAS  
STATE CORPORATION COMMISSION

WELL PLUGGING RECORD

Give All Information Completely  
Make Required Affidavit  
Mail or Deliver Report to  
Conservation Division  
State Corporation Comm.  
245 North Water  
Wichita, KS 67202

Summer County. Sec. 16 Twp. 35 Rge. 4 NE/W  
Location as "NE/CNW $\frac{1}{4}$ SW $\frac{1}{4}$ " or footage from lines  
C, SW, NW, Sec 16-35S-4W, 660' N & 4620' W from SE corner.  
Lease Owner Esther Dalrymple  
Lease Name Dalrymple Well No. 1-16  
Office Address 630 N.E. 63rd Street, Okla. City, OK 73105  
Character of Well (Completed as Oil, Gas or Dry Hole)  
Couldn't get production pipe down hole. (crooked hole)  
Date Well completed March 14 1986  
Application for plugging filed 19  
Application for plugging approved 19  
Plugging commenced March 14 1986  
Plugging completed March 14 1986  
Reason for abandonment of well or producing formation  
Crooked hole, could not get prod pipe in hole.  
If a producing well is abandoned, date of last production  
19  
N/A  
Was permission obtained from the Conservation Division or  
its agents before plugging was commenced? Yes

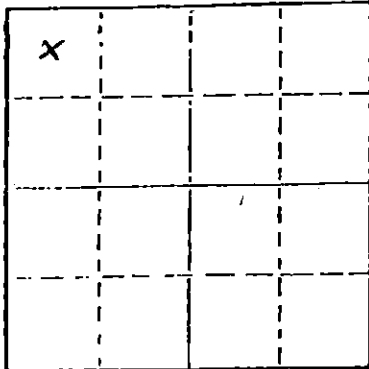

Name of Conservation Agent who supervised plugging of this well Glenn Ward  
Producing formation \_\_\_\_\_ Depth to top \_\_\_\_\_ Bottom \_\_\_\_\_ Total Depth of Well \_\_\_\_\_  
Show depth and thickness of all water, oil and gas formations.

OIL, GAS OR WATER RECORDS

CASING RECORD

FORMATION	CONTENT	FROM	TO	SIZE	PUT IN	PULLED OUT
N/A	N/A	N/A	N/A	N/A	N/A	N/A

Describe in detail the manner in which the well was plugged, indicating where the mud fluid was placed and the method or methods used in introducing it into the hold. If cement or other plugs were used, state the character of same and depth placed, from \_\_\_\_\_ feet to \_\_\_\_\_ feet for each plug set.  
5230 ft depth w/200 sx of 50/50 poz mix, 10% salt.  
1250 ft depth w/35 sx of 50/50 poz mix, 10% salt.  
350 ft depth w/35 sx of 50/50 poz mix, 10 % salt.  
60 ft depth w/25 sx of 50/50 poz mix, 10% salt.  
10 sx in Rathole, 10 sx in Mousehole. Total of 315 sx cement, 50/50 poz mix 10% salt.

(If additional description is necessary, use BACK of this sheet)


Name of Plugging Contractor Western Cementing Company, Enid, Oklahoma

STATE OF Oklahoma COUNTY OF Oklahoma, ss.  
Kathryn McGouran/Production Secretary (employee of owner) or (owner or operator)  
of the above-described well, being first duly sworn on oath, says: That I have knowledge of  
the facts, statements, and matters herein contained and the log of the above-described well  
as filed and that the same are true and correct. So help me God.

(Signature) Kathryn McGouran  
630 N.E. 63rd Street, Okla. City, OK 73105  
(Address)

SUBSCRIBED AND SWORN TO before me this 17th day of March, 1986

My commission expires 6-12-86  
Lana C. Carnahan  
Notary Public.

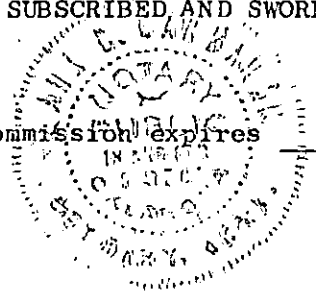

STATE CORPORATION COMMISSION

MAR 19 1986 3-19-86

CONSERVATION DIVISION  
Wichita, Kansas