


15-095-00420-0000

STATE OF KANSAS
STATE CORPORATION COMMISSION
Give All Information Completely
Make Required Affidavit
Mail or Deliver Report to:
Conservation Division
State Corporation Commission
211 No. Broadway
Wichita, Kansas

WELL PLUGGING RECORD

KINGMAN County, Sec. 22 Twp. 29 Rge. 10 (X) W (W)

Location as "NE/CNW/SW" or footage from lines NW NW SE
Lease Owner PETROLEUM, INC.
Lease Name SPADE "E" Well No. 1
Office Address ROUTE 2, GREAT BEND, KANSAS
Character of Well (completed as Oil, Gas or Dry Hole) DRY HOLE
Date well completed January 27, 19 58
Application for plugging filed January 28, 19 58
Application for plugging approved January 31, 19 58
Plugging commenced January 27, 19 58
Plugging completed January 27, 19 58
Reason for abandonment of well or producing formation
No Producing Zones

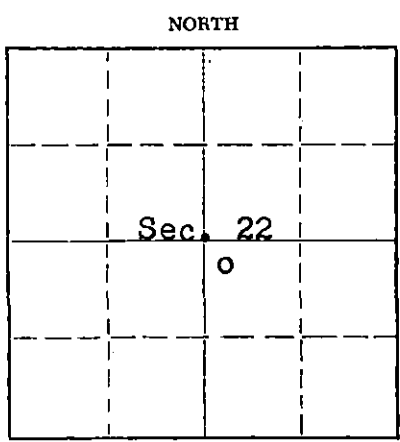

Locate well correctly on above Section Plat

If a producing well is abandoned, date of last production None 19

Was permission obtained from the Conservation Division or its agents before plugging was commenced? Yes

Name of Conservation Agent who supervised plugging of this well Fred W. Hampel, Pretty Prairie, Kansas
Producing formation ----- Depth to top --- Bottom ---- Total Depth of Well 4723 Feet
Show depth and thickness of all water, oil and gas formations.

OIL, GAS OR WATER RECORDS

CASING RECORD

FORMATION	CONTENT	FROM	TO	SIZE	PUT IN	PULLED OUT
				8-5/8"	253.44'	None

Describe in detail the manner in which the well was plugged, indicating where the mud fluid was placed and the method or methods used in introducing it into the hole. If cement or other plugs were used, state the character of same and depth placed, from feet to feet for each plug set.

Mud up with heavy mud to 250' pushed down 1/3 sack hulls to 250' followed by wooden plug. Placed 20 sacks cement through drill pipe on to plug. Mud up to 35' pushed down 1/3 sack hulls to 35' followed by wooden plug and 10 sacks cement to base of well cellar.

STATE CORPORATION COMMISSION
2-11-58
FEB 11 1958
CONSERVATION DIVISION
Wichita, Kansas

(If additional description is necessary, use BACK of this sheet)
Name of Plugging Contractor GARVEY DRILLING COMPANY
Address ROUTE 2, GREAT BEND, KANSAS

STATE OF KANSAS, COUNTY OF BARTON, ss.
Don Searle (employee of owner) or (owner or operator) of the above-described well, being first duly sworn on oath, says: That I have knowledge of the facts, statements, and matters herein contained and the log of the above-described well as filed and that the same are true and correct. So help me God.
(Signature) Don Searle
ROUTE 2, GREAT BEND, KANSAS (Address)

SUBSCRIBED AND SWORN TO before me this 5th day of February, 19 58
Jed A. Brown
My commission expires July 11, 1960 Notary Public.

PLUGGING
FILE SEC. 22 T 29 R 10 W
BOOK PAGE 49 LINE 42

15-095-00420-0000
WELL LOG

COMPANY PETROLEUM, INCORPORATED

SEC. 22 T. 29S R. 10W

FARM SPADE "E" NO. 1

LOC. NW, NW, SE


TOTAL DEPTH 4723'

COUNTY KINGMAN CO., KANSAS

COMM. January 9, 1958

COMP. January 27, 1958

CONTRACTOR GARVEY DRILLING COMPANY

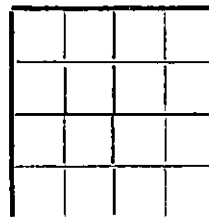

CASING 8 5/8" @ 253.44' W/175 sax.

ELEVATION 1764' DF

PRODUCTION D & A

FIGURES INDICATE BOTTOM OF FORMATIONS

286	Shale, sand & shells
911	Sand, shale & clay
1565	Shale & shells
1880	Shale & lime
1980	Lime
2634	Lime & shale
2875	Shale
3220	Shale & lime
3264	Shale
3327	Lime
3778	Lime & shale
4163	Lime
4310	Shale & lime
4360	Chert
4387	Cherty lime
4595	Shale & lime
4630	Lime
4653	Lime, chert & dolomite
4675	Lime & sand
4703	Sand
4723	Shale
4723	T. D.

RECEIVED
STATE CORPORATION COMMISSION
2-11-58
FEB 11 1958
CONSERVATION DIVISION
Wichita, Kansas

PLUGGING
FILE SEC. 22 T. 29 R. 10 W
BOOK PAGE 79 LINE 44

State of KANSAS }
County of BARTON } ss:

I, VERNE A. MORRIS of GARVEY DRILLING COMPANY

upon oath state that the above and foregoing is a true and correct copy of the log of the #1 SPADE "E" well

Verne A. Morris

Subscribed and sworn to before me this 4th day of February 19 58

My Commission Expires: 2-11-60

Del T. Brown
NOTARY PUBLIC