

15-095-00264-0000


STATE OF KANSAS
STATE CORPORATION COMMISSION

WELL PLUGGING RECORD

Give All Information Completely
Make Required Affidavit
Mail or Deliver Report to:
Conservation Division
State Corporation Commission
211 No. Broadway
Wichita, Kansas

KINGMAN County. Sec. 23 Twp. 29 Rge. 10 ### W (W)

NORTH

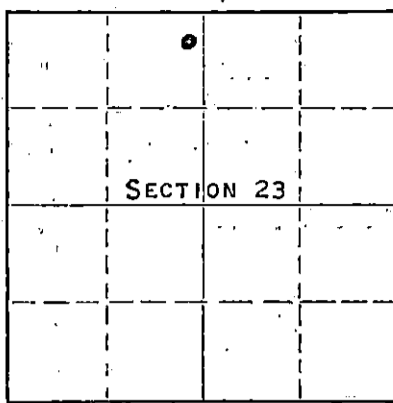

Locate well correctly on above Section Plat

Location as "NE/CNW%SW%" or footage from lines APPROX. NE-NE-NW
Lease Owner PETROLEUM, INC.
Lease Name SPADE Well No. 1
Office Address ROUTE 2, GREAT BEND, KANSAS
Character of Well (completed as Oil, Gas or Dry Hole) DRY HOLE
Date well completed JULY 26 19 57
Application for plugging filed JULY 26 19 57
Application for plugging approved JULY 26 19 57
Plugging commenced JULY 26 19 57
Plugging completed JULY 26 19 57
Reason for abandonment of well or producing formation NO PRODUCIBLE ZONES

If a producing well is abandoned, date of last production NONE 19
Was permission obtained from the Conservation Division or its agents before plugging was commenced? YES

Name of Conservation Agent who supervised plugging of this well M.A. RIVES, PRATT, KANSAS
Producing formation ----- Depth to top ----- Bottom ----- Total Depth of Well 4480' Feet
Show depth and thickness of all water, oil and gas formations.

OIL, GAS OR WATER RECORDS

CASING RECORD

FORMATION	CONTENT	FROM	TO	SIZE	PUT IN	PULLED OUT
				8-5/8"	240'	NONE

Describe in detail the manner in which the well was plugged, indicating where the mud fluid was placed and the method or methods used in introducing it into the hole. If cement or other plugs were used, state the character of same and depth placed, from _____ feet to _____ feet for each plug set.

MUD UP WITH HEAVY MUD TO 235', PUSHED DOWN 1/3 SACK HULLS TO 235'. FOLLOWED BY WOODEN PLUG. PLACED 20 SACKS CEMENT THROUGH DRILL PIPE ON TO PLUG. MUD UP TO 40' AND PLACED 1/3 SACK HULLS AT 40' FOLLOWED BY WOODEN PLUG AND 10 SACKS CEMENT TO BASE OF WELL CELLAR.

(If additional description is necessary, use BACK of this sheet)

Name of Plugging Contractor GARVEY DRILLING COMPANY
Address ROUTE 2, GREAT BEND, KANSAS

STATE OF KANSAS, COUNTY OF BARTON, ss.
C. J. WILTSE (employee of owner) or ~~Notary Public~~ of the above-described well, being first duly sworn on oath, says: That I have knowledge of the facts, statements, and matters herein contained and the log of the above-described well as filed and that the same are true and correct. So help me God.
(Signature) *C. J. Wiltse*
ROUTE 2, GREAT BEND, KANSAS (Address)

SUBSCRIBED AND SWORN to before me this 6TH day of AUGUST 19 57
Ed. T. Brown
My commission expires JULY 11, 1960

PLUGGING
FILE SEC T R
BOOK PAGE LINE

RECEIVED
STATE CORPORATION COMMISSION
8-7-57
AUG 7 1957
CONSERVATION DIVISION
Wichita, Kansas

WELL LOG

15-095-00264-0000

COMPANY **PETROLEUM, INCORPORATED**
FARM **SPADE** NO. **1**


SEC. **23** T. **29S** R. **10W**
LOC. **Approx. NE,NE,NW**

TOTAL DEPTH **4706'**

COUNTY **Kingman Co., Kansas**

COMM. **July 11, 1957** COMP. **July 26, 1957**

CONTRACTOR **GARVEY DRILLING COMPANY**

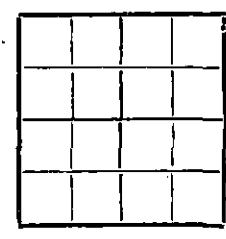

CASING **8 5/8" @ 240' W/175 sax.**

ELEVATION **1687' DF**

PRODUCTION **D & A**

FIGURES INDICATE BOTTOM OF FORMATIONS

35	Sand
80	Red bed & sand
840	Red bed & shells
1895	Shale & shells
3530	Lime & shale
3596	Sandy lime & shale
3703	Lime & shale
4060	Lime
4134	Lime & shale
4247	Lime
4271	Chert
4298	Lime
4445	Shale & lime
4510	Shale
4514	Lime
4525	Lime & chert
4574	Lime
4649	Sand & shale
4706	Lime
4706	T. D.

RECEIVED
STATE CORPORATE COMMISSION
8-7-57
AUG 7 1957
CONSERVATION DIVISION
Wichita, Kansas

PLUGGING
FILE SEC. 23 T. 29 R. 10W
BOOK PAGE 32 LINE 1

State of KANSAS
County of BARTON

I, Verne A. Morris of Garvey Drilling Co.

upon oath state that the above and foregoing is a true and correct copy of the log of the #1 Spade well

Verne A. Morris

Subscribed and sworn to before me this 5th day of August 19 57

My Commission Expires: July 11, 1960

Delbert Brown
NOTARY PUBLIC