


15-095-00598-0000

STATE OF KANSAS  
STATE CORPORATION COMMISSION

WELL PLUGGING RECORD

Give All Information Completely  
Make Required Affidavit  
Mail or Deliver Report to:  
Conservation Division  
State Corporation Commission  
211 No. Broadway  
Wichita, Kansas

Kingman County, Sec. 17 Twp. 30S Rge. (E) 7 (W)

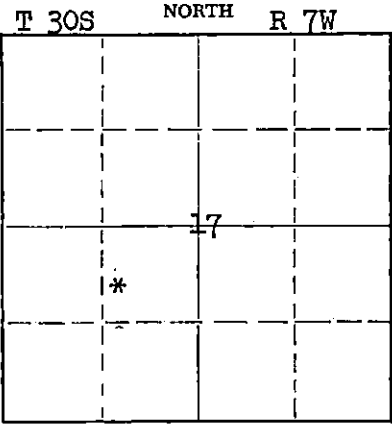

Location as "NE/CNW%SW%" or footage from lines SW NE SW  
Lease Owner Tennessee Gas Transmission Company  
Lease Name James L. Oller Well No. 1  
Office Address Chase, Kansas  
Character of Well (completed as Oil, Gas or Dry Hole) Oil Well  
Date well completed Dec. 7 1955  
Application for plugging filed May 24 1956  
Application for plugging approved May 25 1956  
Plugging commenced Mgy 31 1956  
Plugging completed June 8 1956  
Reason for abandonment of well or producing formation Failure to produce in commercial quantity  
If a producing well is abandoned, date of last production May 19 56  
Was permission obtained from the Conservation Division or its agents before plugging was commenced? Yes

Locate well correctly on above Section Plat

Name of Conservation Agent who supervised plugging of this well Rives  
Producing formation \_\_\_\_\_ Depth to top \_\_\_\_\_ Bottom \_\_\_\_\_ Total Depth of Well 4357 Feet  
Show depth and thickness of all water, oil and gas formations.

OIL, GAS OR WATER RECORDS

CASING RECORD

FORMATION	CONTENT	FROM	TO	SIZE	PUT IN	PULLED OUT
				8-5/8"	222'	None
				5-1/2"	4357'	3451'
				Baker plug set at 4267'. Pipe perforated 4247' to 4260'.		

Describe in detail the manner in which the well was plugged, indicating where the mud fluid was placed and the method or methods used in introducing it into the hole. If cement or other plugs were used, state the character of same and depth placed, from \_\_\_\_\_ feet to \_\_\_\_\_ feet for each plug set.

Filled the hole with sand to 4235' and ran 5 sacks of cement. Pulled casing up to 1800' and circulated hole with 20 sacks of jell mud. Mudded the hole to 220', set a 10' rock bridge and ran 20 sacks of cement. Mudded the hole to 35', set a 10' rock bridge and ran 10 sacks of cement on top. Plugging completed.

6-21-56  
STATE CORPORATION COMMISSION  
WICHITA, KANSAS

(If additional description is necessary, use BACK of this sheet)

Name of Plugging Contractor West Supply Co., Inc.  
Address Chase, Kansas

STATE OF Kansas, COUNTY OF Rice, ss.  
Paul H. Lenhart (employee of owner) or (owner) of the above-described well, being first duly sworn on oath, says: That I have knowledge of the facts, statements, and matters herein contained and the log of the above-described well as filed and that the same are true and correct. So help me God.

(Signature) Paul H. Lenhart  
(Address)

SUBSCRIBED AND SWORN TO before me this 20 day of May, 19 56

My commission expires May 20, 1958

Curran O. Gray  
Notary Public.

PLUGGING  
FILE SEC 17 T 30 R 7W  
BOOK PAGE 64 LINE 35

WELL LOG-----OLLER #1

Location: SW NE SW, Section 17-30-7W,  
Kingman County, Kansas.

OWNER: Tennessee Gas Transmission Company  
ROTARY DRILLING CONTRACTOR: Sterling Drilling Company

COMMENCED: 11-21-55 (w.r.)  
COMPLETED: 12-7-55 (w.r.)

TOTAL DEPTH: 4355'

LOG

CASING RECORD

0-40	Sand
40-180	Red Bed & Shale
180-219	Red Bed
219-720	Shale & Shells
720-1520	Shale & Limestone
1520-1900	Limestone
1900-2560	Limestone & Shale
2560-3065	Limestone
3065-3130	Limestone & Shale
3130-3330	Sand
3330-3510	Limestone
3510-3720	Limestone & Shale
3720-3804	Limestone
3804-3895	Limestone & Shale
3895-3975	Limestone
3975-4194	Limestone & Shale
4194-4355	Limestone T.D.

Set 8-5/8" casing at 219' with 150 sacks cement.

Ran 4355' of 5-1/2" casing with 150 sacks cement.

RECEIVED  
STATE CORPORATION COMMISSION  
MAY 24 1956  
CONSERVATION DIVISION  
Wichita, Kansas

5-24-56

PLUGGING  
FILE SEC. 17 T. 30 R. 7W  
BOOK PAGE 64 LINE 35