


15-095-00007-0000

STATE OF KANSAS
STATE CORPORATION COMMISSION

Give All Information Completely
Make Required Affidavit
Mail or Deliver Report to:
Conservation Division
State Corporation Commission
800 Bittling Building
Wichita, Kansas

WELL PLUGGING RECORD

NORTH

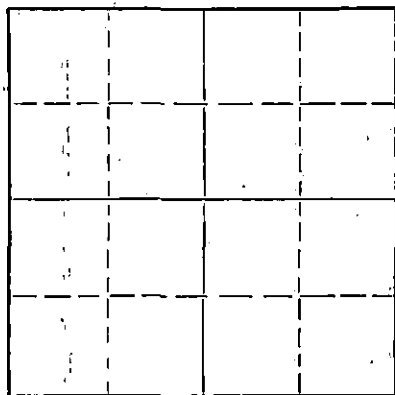

Locate well correctly on above
Section Plat

Kingman County, Sec. 17 Twp. 30 Rge. (E) 7 (W)

Location as "NE/CNW/SW" or footage from lines SW SW SE
Lease Owner P.C. Pickrell Drilling Company
Lease Name Wells-Towner "B" Well No. 1
Office Address 705 Fourth National Bank Bldg., Wichita, Kansas
Character of Well (completed as Oil, Gas or Dry Hole) Dry Hole
Date well completed 3/15 19 56
Application for plugging filed 3/15 19 56
Application for plugging approved 3/15 19 56
Plugging commenced 3/15 19 56
Plugging completed 3/15 19 56
Reason for abandonment of well or producing formation D & A

If a producing well is abandoned, date of last production -0- 19
Was permission obtained from the Conservation Division or its agents before plugging was commenced? Yes

Name of Conservation Agent who supervised plugging of this well M. A. Rives
Producing formation _____ Depth to top _____ Bottom _____ Total Depth of Well 4296 Feet
Show depth and thickness of all water, oil and gas formations.

OIL, GAS OR WATER RECORDS

CASING RECORD

FORMATION	CONTENT	FROM	TO	SIZE	PUT IN	PULLED OUT
		0	160'	8 5/8"	160'	None
		No Oil String Was Run				

Describe in detail the manner in which the well was plugged, indicating where the mud fluid was placed and the method or methods used in introducing it into the hole. If cement or other plugs were used, state the character of same and depth placed, from _____ feet to _____ feet for each plug set.

Filled with heavy mud to 160', bridged hole and cemented with 20 sacks. Then heavy mud to 20' below cellar, bridge hole and cement with 10 sacks to bottom of cellar.

(If additional description is necessary, use BACK of this sheet)

Name of Plugging Contractor Pickrell Drilling Company
Address 705 Fourth National Bank Bldg., Wichita, Kansas

STATE OF KANSAS, COUNTY OF SEDGWICK, ss.
C. W. Sebitts

(employee of owner) or (owner or contractor) of the above-described well, being first duly sworn on oath, says: That I have knowledge of the facts, statements and matters herein contained and the log of the above-described well as filed and that the same are true and correct. So help me God.

(Signature) [Signature]
705 Fourth Nat'l Bank Bldg., Wichita
(Address)

SUBSCRIBED AND SWORN TO before me this 22nd day of March, 1956

My commission expires July 30, 1958

[Signature] Notary Public.

PLUGGING
PLI SEC 17 T 30 R 7W
BOOK PAGE 46 LINE 27

RECEIVED
STATE CORPORATION COMMISSION
MAR 27 1956 3-27-56
CONSERVATION DIVISION
Wichita, Kansas

ROTARY DRILLING LOG

COMPANY: Pickrell Drilling Compant, etal
Wichita, Kansas

Rotary Drilling Commenced March 2, 1956

LOCATION: Wells-Towner "B" #1
SW SW SE 17-30S-7W, Kingman, County, Kansas

Rotary Drilling Completed March 15, 1956

CONTRACTOR: PICKRELL DRILLING COMPANY
Wichita, Kansas

CASING RECORD:

- 4 Jts 8 5/8" Spiral Weld Casing set at 160 feet with 100 sacks cement circulated.
- No oil string was run.

L O G

(Figures indicate bottom of formation - measurements from top of rotary bushing.)

Red Rock	160	Circ. for samples at 4205'
Red Bed & Shale	560	4296
Shale, shells & salt	1035	
Shale & lime	1335	
Lime & shells	1520	
Lime	1950	
Lime & shale	2315	Slope Test @ 3000' - 5° off
Lime	2560	Slope Test @ 4000' - 0° off
Lime & shale	2865	
Lime	3102	S.L.M. at 3000' - O.K.
Lime & shale	3222	S.L.M. at 4000' - O.K.
Lime; shale & shale	3349	
Lime	3890	
Lime & shale	4061	
Lime	4123	
Lime & shale	4186	
Mississippi Lime	4296 RTD	

PLUGGING
 FILE SEC 17 30 R 7W
 BOOK PAGE 46 LINE 27

The undersigned, C. W. Sebitts, Attorney-in-Fact for PICKRELL DRILLING COMPANY, hereby certifies in behalf of said Company, that the above is a true and correct log of the formation encountered in drilling the above well as reflected by the Daily Drilling Reports.

PICKRELL DRILLING COMPANY
By [Signature] Attorney-in-Fact

STATE OF KANSAS,)
COUNTY OF SEDGWICK,) ss.

On this 23rd day of March, 1956, before me the undersigned, a Notary Public, in and for the County and State aforesaid, personally appeared C. W. Sebitts, to me known to be the identical person who subscribed the name of PICKRELL DRILLING COMPANY to the foregoing instrument as its Attorney-in-Fact and acknowledged to me that he executed the same as his free and voluntary act and deed, and as the free and voluntary act and deed of such company, for the uses and purposes therein set forth.

Given under my hand and seal of office the day and year last above written. CONSERVATION DIVISION
Wichita, Kansas
[Signature]
Notary Public

My commission expires July 30, 1958