


Give All Information Completely
Make Required Affidavit
Mail or Deliver Report to:
Conservation Division
State Corporation Commission
211 No. Broadway
Wichita, Kansas

WELL PLUGGING RECORD

NORTH

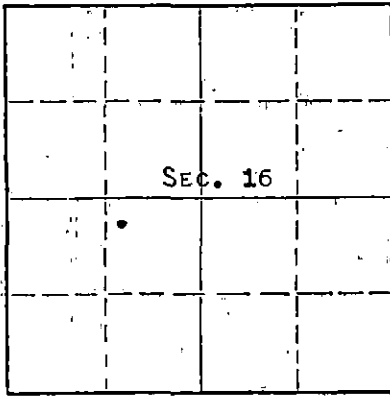

Locate well correctly on above
Section Plat

KINGMAN County. Sec. 16 Twp. 30s Rge. 7W (E) (W)
Location as "NE/CNWSW" or footage from lines NW NE SW
Lease Owner PETROLEUM, INC.
Lease Name LEGG Well No. 1
Office Address R. R. #2, GREAT BEND, KANSAS
Character of Well (completed as Oil, Gas or Dry Hole) DRY HOLE
Date well completed 11-27- 19 63
Application for plugging filed 11-27- 19 63
Application for plugging approved 11-27- 19 63
Plugging commenced 11-27- 19 63
Plugging completed 11-27- 19 63
Reason for abandonment of well or producing formation NO PRODUCIBLE ZONES

If a producing well is abandoned, date of last production 19
Was permission obtained from the Conservation Division or its agents before plugging was commenced? YES

Name of Conservation Agent who supervised plugging of this well ARCHIE ELVING
Producing formation Depth to top Bottom Total Depth of Well 4303 Feet
Show depth and thickness of all water, oil and gas formations.

OIL, GAS OR WATER RECORDS

CASING RECORD

FORMATION	CONTENT	FROM	TO	SIZE	PUT IN	PULLED OUT
				8-5/8	290	NONE

Describe in detail the manner in which the well was plugged, indicating where the mud fluid was placed and the method or methods used in introducing it into the hole. If cement or other plugs were used, state the character of same and depth placed, from feet to feet for each plug set.

MUDDERED UP WITH HEAVY MUD TO 275', FOLLOWED BY WOODEN PLUG, 1/2 SACK HULLS & 25 SACKS CEMENT. MUDDERED UP WITH HEAVY MUD TO 40', FOLLOWED BY 1/2 SACK HULLS & 10 SACKS CEMENT TO BASE OF WELL CELLAR.

RECEIVED
STATE CORPORATION COMMISSION

DEC 9 1963
12-9-63
CONSERVATION DIVISION
Wichita, Kansas

(If additional description is necessary, use BACK of this sheet)
Name of Plugging Contractor GARVEY DRILLING CO.
Address ROUTE #4, GREAT BEND, KANSAS

STATE OF KANSAS COUNTY OF BARTON, ss.
MONTE CHADD (employee of owner) or (owner) of the above-described well, being first duly sworn on oath, says: That I have knowledge of the facts, statements, and matters herein contained and the log of the above-described well as filed and that the same are true and correct. So help me God.

(Signature) MONTE CHADD, DIST. PROD. SUPT.
R. R. #2, GREAT BEND, KANSAS
(Address)

SUBSCRIBED AND SWORN TO before me this 5TH day of DECEMBER 19 63

My commission expires SEPTEMBER 23, 1967

Richard L. ...
Notary Public.

15-095-00488-0000
WELL LOG

COMPANY Petroleum, Inc.

SEC. 16 T. 30S. R. 7W

FARM Legg

NO. 1

LOC. NW NE SW

TOTAL DEPTH 4303'

COUNTY Kingman

COMM. 11-15-63

COMP. 11-27-63

CONTRACTOR Garvey Drilling Company



CASING 8 5/8" @ 290' w/225 sx

ELEVATION 1504' DF

PRODUCTION D & A

FIGURES INDICATE BOTTOM OF FORMATIONS

- 140' Red Rock
- 375' Red Bed and Shale
- 1093' Shale
- 1110' Anhydrite
- 1510' Shale and Lime
- 1785' Lime and Shale
- 2175' Shale and Lime
- 2355' Lime and Shale
- 2555' Shale and Lime
- 2811' Lime and Shale
- 3034' Shale and Lime
- 3355' Lime and Shale
- 3729' Lime
- 3768' Lime and Shale
- 3812' Lime
- 3899' Lime and Chalk
- 3908' Lime
- 3970' Shale and Lime Streaks
- 4175' Lime and Shale
- 4223' Lime
- 4263' Mississippi Lime
- 4303' Lime
- 4303' RTD

RECEIVED
STATE CORPORATION COMMISSION

DEC 9 1963
12-9-63
CONSERVATION DIVISION
Wichita, Kansas

State of Kansas }
County of Barton } SS

I, Sam N. Stephens of Garvey Drilling Company

upon oath state the above and foregoing is a true and correct copy of the log of the Legg #1 well.

Sam N. Stephens

Subscribed and sworn to before me this 4th day of December 1963

My Commission Expires: September 23rd, 1967

Shirley M. Penick
NOTARY PUBLIC