


STATE OF KANSAS
STATE CORPORATION COMMISSION
CONSERVATION DIVISION
P. O. BOX 17027
WICHITA, KANSAS 67217

FORM CP-4

WELL PLUGGING RECORD

Kingman County, Sec. 16 Twp. 30S Rge. 7 (E) W (W)

Location as "NE/CNW&SW" or footage from lines SE NE NE
Lease Owner McGoy Petroleum Co.
Lease Name Simon Well No. 1
Office Address 816 Vickers KSB & T Bldg, Wichita, Kansas 67202
Character of Well (completed as Oil, Gas or Dry Hole) D & A
Date well completed 9-26 1976
Application for plugging filed 9-26 1976
Application for plugging approved 9-26 1976
Plugging commenced 9-26 1976
Plugging completed 9-26 1976
Reason for abandonment of well or producing formation D & A

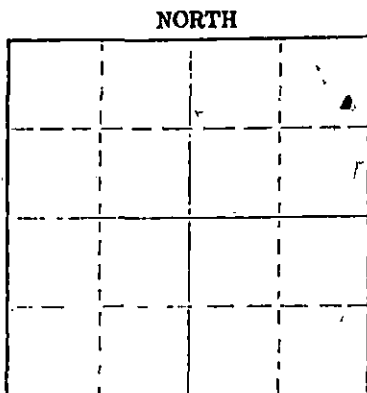

Locate well correctly on above Section Plot

If a producing well is abandoned, date of last production 19
Was permission obtained from the Conservation Division or its agents before plugging was commenced? Yes

Name of Conservation Agent who supervised plugging of this well Russ Bieberstein
Producing formation _____ Depth to top _____ Bottom _____ Total Depth of Well _____
Show depth and thickness of all water, oil and gas formations

OIL, GAS OR WATER RECORDS

CASING RECORD

FORMATION	CONTENT	FROM	TO	SIZE	PUT IN	PULLED OUT
Surface pipe		0	303	8 5/8"	303	None

Describe in detail the manner in which the well was plugged, indicating where the mud fluid was placed and the method or methods used in introducing it into the hole. If cement or other plugs were used, state the character of same and depth placed, from _____ feet to _____ feet for each plug set.

Filled hole with heavy mud.

#1 plug set @ 300' with 50 sks. cement.

#2 plug set @ 40' with 15 sks. cement.

#3 plug set in rat hole with 5 sks. cement.

RECEIVED
STATE CORPORATION COMMISSION
OCT 07 1976
10-7-76
CONSERVATION DIVISION
Wichita, Kansas

(If additional description is necessary, use BACK of this sheet)
Name of Plugging Contractor Sweetman Drilling, Inc.
Address Box 645, Great Bend, Kansas 67530

STATE OF Kansas COUNTY OF Barton, ss.

Gary L. Hawk


(employee of owner) or ~~owner~~ operator of the above-described well, being first duly sworn on oath, says: That I have knowledge of the facts, statements, and matters herein contained and the log of the above-described well as filed and that the same are true and correct. So help me God.

(Signature) Gary L. Hawk
Box 645, Great Bend, Kansas 67530
(Address)

SUBSCRIBED AND SWORN TO before me this 5th day of October, 1976

My commission expires 7-10-77

Mary Ann Schwaborn
Notary Public.

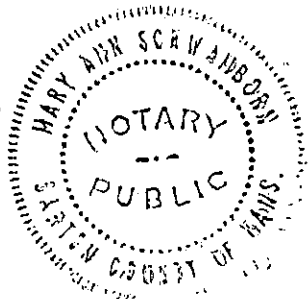

WELL LOG
Simon #1
SE NE NE 16-30-7W
Kingman County, Kansas

Name of Operator: McGoy Petroleum Co.
816 Vickers KSB & T Bldg.
Wichita, Kansas 67202

Date Completed: September 26, 1976

<u>FROM</u>	<u>TO</u>	
0	45	Sand
.45	1075	Red bed and shale
1075	3881	Lime and shale
3881	4160	Lime
4160		Total Depth.

RECEIVED
STATE CORPORATION COMMISSION

OCT 07 1976
10-7-76
CONSERVATION DIVISION
Wichita, Kansas

STATE OF KANSAS

COUNTY OF BARTON ss

Gary L. Hawk, Secretary of Sweetman Drilling, Inc., being first duly sworn on oath says: That I have knowledge of the facts, statements and matters herein contained and the log of the above described well as filed and that the same are true and correct.

Gary L. Hawk
Gary L. Hawk

Subscribed and sworn before me this 5th day of October, 1976.

Mary Ann Schwamborn
Notary Public Barton County

My Commission Expires 7-10-76

