


STATE OF KANSAS
STATE CORPORATION COMMISSION

Give All Information Completely
Make Required Affidavit
Mail or Deliver Report to:
Conservation Division
State Corporation Commission
211 No. Broadway
Wichita, Kansas

WELL PLUGGING RECORD

NORTH

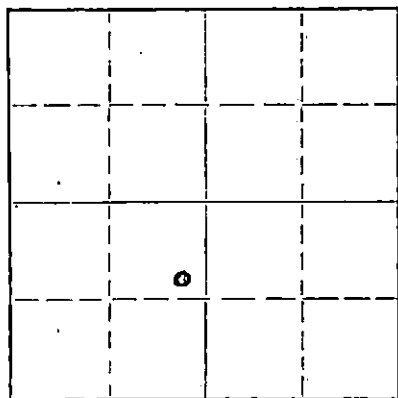

Locate well correctly on above
Section Plat

Kingman County. Sec. 15 Twp. 30S Rge. (E) 7 (W)
Location as "NE/CNW/SW" or footage from lines S₈-NE-SW
Lease Owner Wilcox Oil Company
Lease Name Kinert Well No. 1-A
Office Address Box 1440, Tulsa, Oklahoma
Character of Well (completed as Oil, Gas or Dry Hole) Dry Hole
Date well completed December 13 19 55
Application for plugging filed January 26 19 56
Application for plugging approved December 19 19 55
Plugging commenced December 20 19 55
Plugging completed December 23 19 55
Reason for abandonment of well or producing formation. No shows to warrant
setting pipe.
If a producing well is abandoned, date of last production 19
Was permission obtained from the Conservation Division or its agents before plugging was commenced? Yes

Name of Conservation Agent who supervised plugging of this well Edwards
Producing formation --- Depth to top --- Bottom --- Total Depth of Well 4807 Feet
Show depth and thickness of all water, oil and gas formations.

OIL, GAS OR WATER RECORDS

CASING RECORD

FORMATION	CONTENT	FROM	TO	SIZE	PUT IN	PULLED OUT
					None	

Describe in detail the manner in which the well was plugged, indicating where the mud fluid was placed and the method or methods used in introducing it into the hole. If cement or other plugs were used, state the character of same and depth placed, from --- feet to --- feet for each plug set.

Hole filled with rotary mud and plugged in accordance with the rules and regulations of the Kansas Corporation Commission as supervised by Mr. Edwards, Commission field agent, and Roy Deck, Wilcox Oil Company representative.

(This well, formerly the KINERT #1, was drilled and completed as a dry hole in January, 1943. It was washed down and re-tested in December, 1955--no shows.)

(If additional description is necessary, use BACK of this sheet)

Name of Plugging Contractor none
Address

STATE OF Oklahoma, COUNTY OF Tulsa, ss.

I, William R. Gall (employee of owner) or (owner or operator) of the above-described well, being first duly sworn on oath, says: That I have knowledge of the facts, statements, and matters herein contained and the log of the above-described well as filed and that the same are true and correct. So help me God.

(Signature)

William R. Gall

Box 1440, Tulsa, Oklahoma


(Address)

SUBSCRIBED AND SWORN to before me this 30th day of January, 1956

My commission expires

1-8-59

Notary Public.

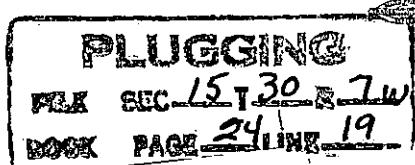

1-3-56