

WELL PLUGGING RECORD

Give All Information Completely  
Map Required Affidavit  
Mail or Deliver Report to:  
Conservation Division  
State Corporation Commission  
212 No. Market  
Wichita, Kansas

Kingman County, Sec. 15 Twp. 30S Rge. 7W (E) (W)

Location as "NE/CNWxSWx" or footage from lines SW SW NE

Lease Owner Tenneco Oil Company

Lease Name Kinert Gilchrist LKC Unit Well No. 8

Office Address Suite 139, Ciudad Bldg., 3000 United Founders Blvd.

Character of Well (completed as Oil, Gas or Dry Hole) Oil

Date well completed 4-9 19 56

Application for plugging filed 11-4 19 83

Application for plugging approved N.A. 19


Plugging commenced 12-1 19 83

Plugging completed 12-6 19 83

Reason for abandonment of well or producing formation Low Oil Production

If a producing well is abandoned, date of last production N.A. 19

Was permission obtained from the Conservation Division or its agents before plugging was commenced? Yes

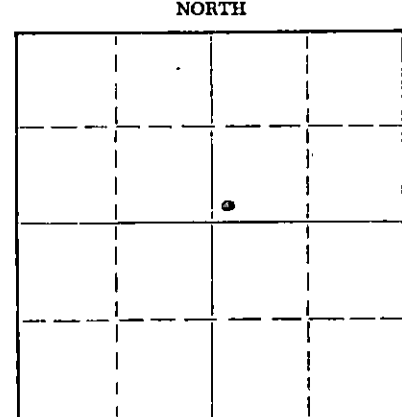

Locate well correctly on above Section Plat

Name of Conservation Agent who supervised plugging of this well \_\_\_\_\_

Producing formation Lansing Kansas City Depth to top 3672 Bottom 3676 Total Depth of Well \_\_\_\_\_ Feet

Show depth and thickness of all water, oil and gas formations.

OIL, GAS OR WATER RECORDS

CASING RECORD

FORMATION	CONTENT	FROM	TO	SIZE	PUT IN	PULLED OUT
Lansing Kansas City	Oil	3672	3676	8-5/8"	160	None
				5-1/2"	2179	635

Describe in detail the manner in which the well was plugged, indicating where the mud fluid was placed and the method or methods used in introducing it into the hole. If cement or other plugs were used, state the character of same and depth placed, from \_\_\_\_\_ feet to \_\_\_\_\_ feet for each plug set.

- 12-1-83 MIRU PU-dug out cellar, set dead men - pulled 107-3/4" rods, 40-5/8" rods, 1-4' - 3/4" pony rod-LD in singles, Rigged over to pull tbg., SD.
- 12-2-83 Had trouble unseating Baker AD 1 pkr - worked with pkr until 11:00 AM - finally came unseated LD 3 jts 2-3/8" tbg in singles, 1-4' sub-1-8' sub. Came out of hole w/116 jts 2-3/8" tbg. - stood in derrick in doubles. Ran back in hole w/EZSU Halliburton retainer & 116 jts. 2-3/8" tbg.-set retainer @ 3620'. Pumped 100 sx. 60-40 pos, 3% gel - left 2 bbl cmt in tbg. & pulled stinger out & came out of hole w/tbg. & retainer - LD in singles 119 jts. 2-3/8" total 1-4', 1-8' sub. Loaded hole w/9# gel, Rigged over for 5-1/2-elevators, slips, etc. SD.
- 12-5-83 Worked pipe-pulled 10" stretch @ 60,000# - pulled 12-1/2" stretch @ 90,000# - calculated free pt @ 1678'. RIH w/csg. cutter-couldn't get cutter to go down past 675' - RIH w/3-1/2" sd pump - couldn't get below 690' - picked up a few chunks of thick mud - RIH w/csg. cutter-shot pipe off @ 635'. Pulled 20 jts. of 5-1/2", 14# csg. & LD.
- 12-6-83 Pumped 100 sx. 60-40 pos, 3% gel, 3% CaCl for top plug.

RECEIVED  
STATE CORPORATION COMMISSION  
2-23-84  
FEB 23 1984

(If additional description is necessary, use BACK of this sheet)


Name of Plugging Contractor Pratt Well Service CONSERVATION DIVISION  
Address P. O. Box 847, Pratt, Kansas, 67124 Wichita, Kansas

STATE OF Oklahoma COUNTY OF Oklahoma, ss.  
Employee of Owner (employee of owner) or (owner or operator) of the above-described well, being first duly sworn on oath, says: That I have knowledge of the facts, statements, and matters herein contained and the log of the above-described well as filed and that the same are true and correct. So help me God.

(Signature) Kirk S. Harbert Kirk S. Harbert  
Production Analyst  
Suite 139, Ciudad Bldg. 3000 United Founders  
Blvd., Okla. City, OK (Address) 73112

Subscribed AND Sworn to before me this 30th day of February, 19 84  
Doreen A. Kemler  
Notary Public.

My commission expires May 7, 1985

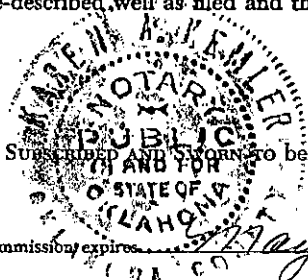

STATE OF KANSAS  
STATE CORPORATION COMMISSION  
200 Colorado Derby Bldg.  
Wichita, Kansas 67202

Form CP-4  
Rev. 12-15-80

WELL PLUGGING RECORD

Give All Information Completely  
Make Required Affidavit

COUNTY Kingman SEC. 15 TWP. 30S RGE. 7 XE/W  
Location as in quarters or footage from lines:


Lease Owner Tenneco  
 Lease Name KGLKCU Well No. 8  
 Office Address Box 1485 Great Bend, Kansas 67530  
 Character of Well (Completed as Oil, Gas or Dry Hole): Oil  
 Date Well Completed April 8, 1956  
 Application for plugging filed October, 1983  
 Plugging commenced Dec. 1, 1983  
 Plugging completed Dec. 6, 1983  
 Reason for abandonment of well or producing formation Not economical to produce

Locate Well  
correctly on above  
Section Platt.

Was permission obtained from the Conservation Division or it's  
Agent's before plugging was commenced? yes

Name of Conservation Agent who supervised plugging of this well Morris Lesley

Producing formation Lansing-KC Depth to top \_\_\_\_\_ bottom T.D. 4180'  
Show depth and thickness of all water, oil and gas formations. PBTD 4163'

OIL, GAS OR WATER RECORDS Casing Record


Formation	Content	From	To	Size	Put in	Pulled Out
		0		8 5/8		0
				5 1/2		20 jts.

Describe in detail the manner in which the well was plugged, indicating where the mud  
fluid was placed and the method or methods used in introducing it into the hold. If cement  
or other plugs were used, state the character of same and depth placed, from \_\_\_\_\_ feet  
to \_\_\_\_\_ feet for each plug set. Perfs. at 3672-76 and 3131-34'  
Pumped 50 sx. cement above and below Hallco EZSU cement retainer at 3620'.  
Top hole plugging, 100 sx. cement 60/40 poz mix, 3% CC, 3% gel.  
Pipe shot off at 650'.

(If additional description is necessary, use BACK of this sheet)

Name of Plugging Contractor Pratt Well Service, Inc.

STATE OF Kansas COUNTY OF Pratt, ss.  
Judy Berry (employee of owner) or (~~owner or operator~~) of the  
 above-described well, being first duly sworn on oath, says: That I have knowledge of the  
 facts, statements, and matters herein contained and the log of the above-described well as  
 filed and that the same are true and correct. So help me God.

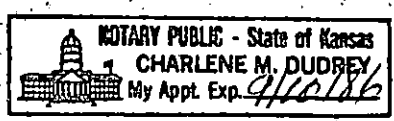

(Signature) Judy Berry  
Box 847 Pratt, KS.  
 (Address)

SUBSCRIBED AND SWORN TO before me this 19th day of March, 1984

My Commission expires: 9/21/86

Charlene M. Dudley  
 Notary Public.  
 RECEIVED  
 STATE CORPORATION COMMISSION  
 MAR 21 1984  
 CONSERVATION DIV.  
 WICHITA, K.