


STATE OF KANSAS  
STATE CORPORATION COMMISSION

Give All Information Completely  
Make Required Affidavit  
Mail or Deliver Report to:  
Conservation Division  
State Corporation Commission  
212 No. Market  
Wichita, Kansas

WELL PLUGGING RECORD

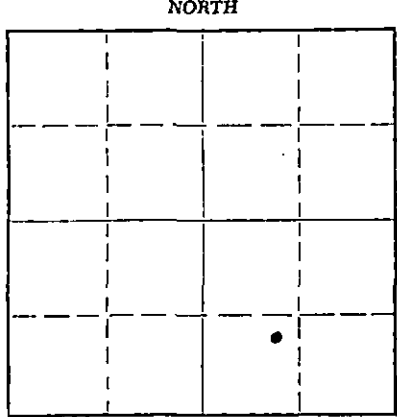

Kingman County, Sec. 15 Twp. 30S Rge. 7W (E) (W)  
Location as "NE/CNW/SW" or footage from lines NE SW SE  
Lease Owner Tenneco Oil Company  
Lease Name Kinert Gilchrist Gas Unit Well No. 6  
Office Address Suite 139, Ciudad Bldg., 3000 United Founders Blvd.  
Oklahoma City, OK, 73112  
Character of Well (completed as Oil, Gas or Dry Hole) Gas  
Date well completed 11-3 19 60  
Application for plugging filed 11-4 19 83  
Application for plugging approved N.A. 19       
Plugging commenced 1-17 19 84  
Plugging completed 1-23 19 84  
Reason for abandonment of well or producing formation Miss. Uneconomical,  
High line pressure, high water production, low gas production  
If a producing well is abandoned, date of last production N.A. 19       
Was permission obtained from the Conservation Division or its agents before plugging was commenced? Yes

Locate well correctly on above Section Plat

Name of Conservation Agent who supervised plugging of this well \_\_\_\_\_  
Producing formation Mississippi Depth to top 4158 Bottom 4165 Total Depth of Well 4250 Feet  
Show depth and thickness of all water, oil and gas formations.

OIL, GAS OR WATER RECORDS

CASING RECORD

| FORMATION   | CONTENT | FROM | TO   | SIZE   | PUT IN | PULLED OUT |
|-------------|---------|------|------|--------|--------|------------|
| Mississippi | Oil     | 4158 | 4165 | 8-5/8" | 273'   | None       |
|             |         |      |      | 5-1/2" | 4229'  | 2700       |
|             |         |      |      |        |        |            |
|             |         |      |      |        |        |            |
|             |         |      |      |        |        |            |
|             |         |      |      |        |        |            |

Describe in detail the manner in which the well was plugged, indicating where the mud fluid was placed and the method or methods used in introducing it into the hole. If cement or other plugs were used, state the character of same and depth placed, from \_\_\_\_\_ feet to \_\_\_\_\_ feet for each plug set.

1-17-84 MIRU PWS pulled 2 jts. of 2-7/8" tbg. RU 1 jt of 2-3/8" tbg w/4-1/2" sledge on btm & RIH on sd line to approx 1000' no other tbg in hole. SD moved 2-3/8" workstring from KGLKCU #10 to #6.

1-19-84 Put on Halliburton EZSU cmt ret & RIH on 128 jts 2-3/8" tbg-set retainer @ 3970' - pumped 100 sx 60-40 pos, 3% gel, 3% CaCl for btm. plug. Pulled tbg. & LD in singles. Rigged over for 5-1/2". Loaded hole w/gel. SD (Halliburton brought 100 extra sx. cmt). Fill to surface on Hopper #1, KGLKCU #3, #2, #1.

1-30-84 MIRU Wiretech RIH W/csg cutter, tagged top of btm plug @ 3571'. Cut csg. @ 2700'. Pulled 82 jts. of 5-1/2" & LD. RD, released PWS.


1-23-84 MIRU Halliburton pumped 100 sx, 60-40 pos, 3% gel, 3% CC for top. Plug filled to surface on KGGU #10, KGLKCU #9, J. Kinert #11, KGLKCU #10.

(If additional description is necessary, use BACK of this sheet)

Name of Plugging Contractor Pratt Well Service  
Address P. O. Box 847, Pratt, Kansas, 67124

STATE OF Oklahoma, COUNTY OF Oklahoma, ss.  
Employee of Owner (employee of owner) or (owner or operator) of the above-described well, being first duly sworn on oath, says: That I have knowledge of the facts, statements, and matters herein contained and the log of the above-described well as filed and that the same are true and correct. So help me God.

(Signature) Kirk S. Harbert Kirk S. Harbert  
Suite 139, Ciudad Bldg., 3000 United Founders  
Blvd., Okla. City, OK, 73112  
(Address)

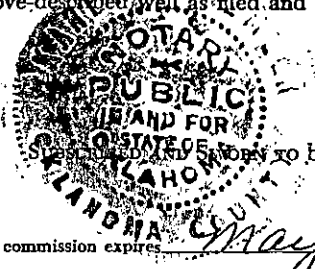

Subscribed and sworn to before me this 20<sup>th</sup> day of February, 19 84  
Haren B. Kiemler  
Notary Public.  
My commission expires May 7, 1985

RECEIVED  
STATE CORPORATION COMMISSION

FEB 23 1984 2-23-84