


Give All Information Completely  
Make Required Affidavit  
Mail or Deliver Report to:  
Conservation Division  
State Corporation Commission  
212 No. Market  
Wichita, Kansas

WELL PLUGGING RECORD

Kingman County, Sec. 25 Twp. 29 Rge. 7 (E) (W)

Location as "NE/CNW/SW" or footage from lines Ne Ne Sw  
Lease Owner Pickrell Drlg. Co.  
Lease Name Millard B Well No. 1  
Office Address 705 4th Nat'l Bank Bldg. Wichita, Ks.  
Character of Well (completed as Oil, Gas or Dry Hole) Oil well  
Date well completed 3-5-64 19\_\_  
Application for plugging filed 12-1-66 19\_\_  
Application for plugging approved 12-2-66 19\_\_  
Plugging commenced 12-2-66 19\_\_  
Plugging completed 12-5-66 19\_\_  
Reason for abandonment of well or producing formation depleted

NORTH

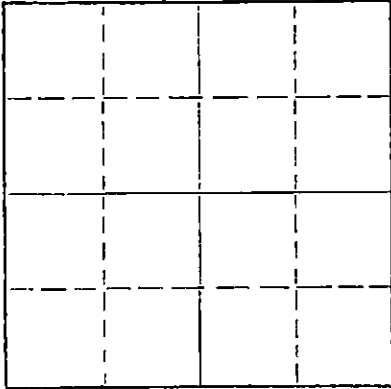

Locate well correctly on above  
Section Flat

If a producing well is abandoned, date of last production 19\_\_  
Was permission obtained from the Conservation Division or its agents before plugging was commenced? yes

Name of Conservation Agent who supervised plugging of this well Archie Elving  
Producing formation \_\_\_\_\_ Depth to top \_\_\_\_\_ Bottom \_\_\_\_\_ Total Depth of Well 4225 Feet  
Show depth and thickness of all water, oil and gas formations.

OIL, GAS OR WATER RECORDS

CASING RECORD

FORMATION	CONTENT	FROM	TO	SIZE	PUT IN	PULLED OUT
				8 5/8	243'	none
				5 1/2	4221	3350'

Describe in detail the manner in which the well was plugged, indicating where the mud fluid was placed and the method or methods used in introducing it into the hole. If cement or other plugs were used, state the character of same and depth placed, from \_\_\_\_\_ feet to \_\_\_\_\_ feet for each plug set.

Fill hole with gravel to 4100' and dump 5 sacks of cement

Set 10' rock bridge from 240' to 230' and dump 25 sacks of cement

Mud hole to 40', rock to 30' and dump 10 sacks of cement to surface

RECEIVED  
STATE CORPORATION COMMISSION

DEC 15 1966

CONSERVATION DIVISION  
Wichita, Kansas

(If additional description is necessary, use BACK of this sheet)  
Name of Plugging Contractor Flint Engineering and Const. Co.  
Address 2375 W. Central El Dorado, Kansas

STATE OF Kansas, COUNTY OF Butler, ss.

\_\_\_\_\_(employee of owner) or (owner or operator) of the above-described well, being first duly sworn on oath, says: That I have knowledge of the facts, statements, and matters herein contained and the log of the above-described well as filed and that the same are true and correct. So help me God.

(Signature) James A. Davis

(Address)

SUBSCRIBED AND SWORN TO before me this 14 day of December, 19 66

My commission expires Sept. 27, 1967

Ronald R. Haire

ROTARY DRILLING LOG

COMPANY: PICKRELL DRILLING COMPANY  
705 4th National Bank Bldg.  
Wichita 2, Kansas  
LOCATION: Millard "B" No. 1, NE NE SW Section 25-29-7W,  
Kingman County, Kansas

Rotary Drilling Commenced 2-22-64  
Rotary Drilling Completed 3--5-64

CONTRACTOR: PICKRELL DRILLING COMPANY  
Wichita, Kansas

CASING RECORD: 243' (12 jts) 8 5/8" surface casing set with 190 sacks cement.  
Circulated. (123 jts) 5 1/2" casing set at 4221' with 125  
sacks cement. Completed 9:45 P.M. March 4, 1964.

LOG

(Figures indicate bottom of formation — measurements from top of rotary bushing.)

60	Sand	<u>C. F. S.</u>
244	Red Rock	4119
970	Red Rock & Shale	4130
1490	Lime & Shale	4140
1690	Lime	4150
3270	Lime & Shale	4160
3855	Lime	4170
4084	Lime & Shale	4205
4123	Shale	4225
4225	Mississippian -RTD	

Slope Test  
1500  
2500  
3500  
4000

S. L. M.  
2207  
2978  
3653

RECEIVED  
STATE CORPORATION COMMISSION

DEC 15 1966

CONSERVATION DIVISION  
Wichita, Kansas

The undersigned, C. W. SEBITS, Attorney-in-Fact for PICKRELL DRILLING COMPANY, hereby certifies in behalf of said Company, that the above is a true and correct log of the formation encountered in drilling the above well as reflected by the Daily Drilling Reports.

PICKRELL DRILLING COMPANY

By C. W. SEBITS Attorney-in-Fact

STATE OF KANSAS }  
COUNTY OF SEDGWICK } ss.:

On this 9th day of March, 1964, before me the undersigned, a Notary Public, in and for the County and State aforesaid, personally appeared C. W. SEBITS, to me known to be the identical person who subscribed the name of PICKRELL DRILLING COMPANY to the foregoing instrument as its Attorney-in-Fact and acknowledged to me that he executed the same as his free and voluntary act and deed and as the free and voluntary act and deed of such company, for the uses and purposes therein set forth.

Given under my hand and seal of office the day and year last above written.

My commission expires: June 21, 1966

Maxine  
Maxine Blackman Notary