


STATE OF KANSAS
STATE CORPORATION COMMISSION

Form CP-4

Give All Information Completely
Make Required Affidavit
Mail or Deliver Report to:
Conservation Division
State Corporation Commission
212 No. Market
Wichita, Kansas 67202

WELL PLUGGING RECORD

Kingman County, Sec 25 Twp. 29 Rge. 7 (E) W (W)
Location as "NE/CNW/SW" or footage from lines C SE NE
Lease Owner Pickrell Drlg. Co. ; Wichita, Kansas 67202
Lease Name Maple 'A' Well No# 1
Office Address 705 Fourth National Bank Building
Character of Well (completed as Oil, Gas or Dry Hole) Oil Well
Date well completed March 23 19 62
Application for plugging filed May 17 19 71
Application for plugging approved May 17 19 71
Plugging commenced May 17 19 71
Plugging completed June 1 19 71
Reason for abandonment of well or producing formation Well Depleted

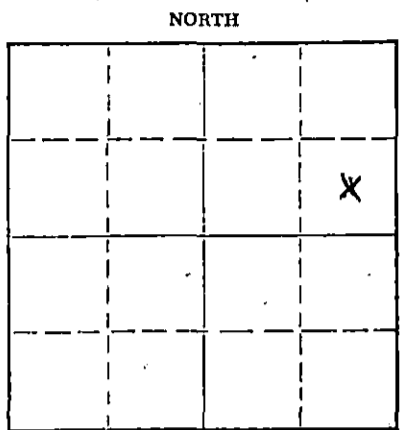

Locate well correctly on above
Section Plat

If a producing well is abandoned, date of last production April 30 19 71
Was permission obtained from the Conservation Division or its agents before plugging was commenced? Yes

Name of Conservation Agent who supervised plugging of this well Russell Biberstein
Producing formation Mississippian Depth to top 4148 Bottom 4208 Total Depth of Well 4302 Feet
Show depth and thickness of all water, oil and gas formations.

OIL, GAS OR WATER RECORDS

CASING RECORD

FORMATION	CONTENT	FROM	TO	SIZE	PUT IN	PULLED OUT
				8 5/8	203	None
				4 1/2	4242	3825

Describe in detail the manner in which the well was plugged, indicating where the mud fluid was placed and the method or methods used in introducing it into the hole. If cement or other plugs were used, state the character of same and depth placed, from _____ feet to _____ feet for each plug set.

May 17, 1971
Plugged off bottom. Dumped sand to 4125'. Mixed and dumped 4 sx of cement to 4125'.

June 1, 1971
Set 10' rock bridge at 200'. Filled 8 5/8" surface casing from 200' to base of cellar with 3000 lb. P.S.T. ready mix concrete.

RECEIVED
STATE CORPORATION COMMISSION
JUN 8 1971
CONSERVATION DIVISION
Wichita, Kansas

(If additional description is necessary, use BACK of this sheet)
Name of Plugging Contractor RUSS CASING PULLING, INC.
Address P. O. Box 1082 Great Bend, Kansas 67530

STATE OF Kansas, COUNTY OF Sedgwick, ss.
Dale M. Robinson (employee of owner) or (owner or operator) of the above-described

well, being first duly sworn on oath, says: That I have knowledge of the facts, statements, and matters herein contained and the log of the above-described well as filed and that the same are true and correct. So help me God.



(Signature) Dale M. Robinson
Date May 17 1971
705 Fourth National Bank Bldg., Wichita, Kansas
(Address)

SUBSCRIBED AND SWORN to before me this 7th day of June, 19 71
Esther Lamone
Notary Public.
My commission expires January 19, 1973

File Copy 15-095-01215-0000
ROTARY DRILLING LOG

COMPANY: PICKRELL DRILLING COMPANY
705 Fourth National Bank Bldg.
Wichita 2, Kansas

LOCATION: MAPLE "A" #1 - C SE NE - Sec. 25-29S-7W
Kingman County, Kansas

Rotary Drilling Commenced 3-13-62
Rotary Drilling Completed 3-23-62

CONTRACTOR: PICKRELL DRILLING COMPANY
Wichita, Kansas

CASING RECORD: Set 205.5' (7 jts) 8 5/8" 20# Surface Casing w/190 sacks cement. Circulated.
Set 4287.19' (136 jts) 4 1/2" 9.5# J-55 Smls Casing, cemented w/100 sacks cement.
Completed @ 6:30 A.M. 3-24-62

LOG

(Figures indicate bottom of formation — measurements from top of rotary bushing.)

60 - Sand 205 - Red Rock 755 - Red Rock, shale 1245 - Shale & Lime 1795 - Lime 2981 - Lime & Shale 3115 - Lime, shale, and sand 3270 - Lime, sand & shale 3345 - Lime & Shale 3802 - Lime 4144 - Lime & Shale 4300 - Mississippian T.D.	<p style="text-align: center;"><u>Circulated for Samples</u></p> 4156' 4166' 4176' 4186' 4196' 4210' 4260' 4300'
--	---

Slope Test

1300'	0°
2300'	0°
3300'	0°
4300'	0°

S. L. M.

2425'
3345'
4058'

RECEIVED
STATE CORPORATION COMMISSION
MAY 17 1971
CONSERVATION DIVISION
Wichita, Kansas

The undersigned, C. W. Sebitts, Attorney-in-Fact for PICKRELL DRILLING COMPANY, hereby certifies in behalf of said Company, that the above is a true and correct log of the formation encountered in drilling the above well as reflected by the Daily Drilling Reports.

PICKRELL DRILLING COMPANY
By C. W. Sebitts Attorney-in-Fact

STATE OF KANSAS }
COUNTY OF SEDGWICK } ss.:

On this 3rd day of April, 19 62, before me the undersigned, a Notary Public, in and for the County and State aforesaid, personally appeared C. W. Sebitts; to me known to be the identical person who subscribed the name of PICKRELL DRILLING COMPANY to the foregoing instrument as its Attorney-in-Fact and acknowledged to me that he executed the same as his free and voluntary act and deed, and as the free and voluntary act and deed of such company, for the uses and purposes therein set forth.

Given under my hand and seal of office the day and year last above written.

My commission expires: September 24, 1962

Maxine Johnson
Maxine Johnson Notary Public