


WELL PLUGGING RECORD

Give All Information Completely
Make Required Affidavit
Mail or Deliver Report to:
Conservation Division
State Corporation Commission
212 No. Market
Wichita, Kansas

Kingman County, Sec. 25 Twp. 29S Rge. ~~7~~ 7 (W)

Location as "NE/CNW/SW" or footage from lines SW SW NW
Lease Owner Pickrell Drilling Company
Lease Name Maple "E" Well No. 1
Office Address 705 Fourth National Bank Building, Wichita, Kansas 67202
Character of Well (completed as Oil, Gas or Dry Hole) Oil
Date well completed August 19 19 60
Application for plugging filed August 12 19 70
Application for plugging approved August 12 19 70
Plugging commenced August 14 19 70
Plugging completed August 18 19 70
Reason for abandonment of well or producing formation Depleted

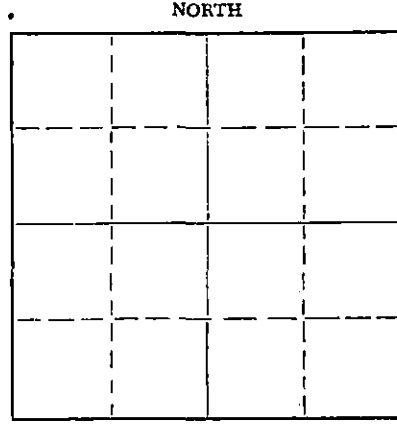

Locate well correctly on above Section Plat

If a producing well is abandoned, date of last production July 7 19 70
Was permission obtained from the Conservation Division or its agents before plugging was commenced? Yes

Name of Conservation Agent who supervised plugging of this well Russell Biberstein
Producing formation Mississippi Chat Depth to top 4131 Bottom Total Depth of Well 4270 Feet
Show depth and thickness of all water, oil and gas formations.

OIL, GAS OR WATER RECORDS

CASING RECORD

FORMATION	CONTENT	FROM	TO	SIZE	PUT IN	PULLED OUT
				8-5/8"	261'	None
				5-1/2"	4268'	3516'

Describe in detail the manner in which the well was plugged, indicating where the mud fluid was placed and the method or methods used in introducing it into the hole. If cement or other plugs were used, state the character of same and depth placed, from _____ feet to _____ feet for each plug set.

August 14, 1970 Plugged off bottom. Dumped sand to 4100'. Mixed and dumped 5 sx of cement to 4060'.


August 18, 1970 Plugged off top. Set 10' rock bridge from 220' to 230'. Filled 8-5/8" surface casing with 3000 lb. P.S.I. ready mix concrete, from 220' to base of cellar.

RECEIVED
STATE CORPORATION COMMISSION
SEP 21 1970
CONSERVATION DIVISION
Wichita, Kansas

(If additional description is necessary, use BACK of this sheet)
Name of Plugging Contractor Russ Casing Pulling, Inc.
Address P. O. Box 1082, Great Bend, Kansas 67530

STATE OF Kansas COUNTY OF Sedgwick, ss.
Dale M. Robinson (employee of owner) or (owner or operator) of the above-described well, being first duly sworn on oath, says: That I have knowledge of the facts, statements, and matters herein contained and the log of the above-described well as filed and that the same are true and correct. So help me God.

(Signature) Dale M. Robinson
705 Fourth National Bank Bldg., Wichita, Kansas
(Address)

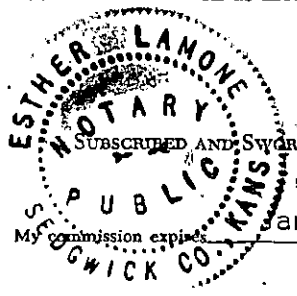

Subscribed and sworn to before me this 18th day of September, 1970
Esther Lamone
Notary Public.

ROTARY DRILLING LOG

COMPANY: Pickrell Drilling Company
705 Fourth National Bank Bldg.
Wichita, Kansas

Rotary Drilling Commenced 7-28-60

LOCATION: Maple "E" #1
SW-SW-NW Section 25-29S-7W
Kingman County, Kansas

Rotary Drilling Completed 8-10-60

CONTRACTOR: **PICKRELL DRILLING COMPANY**
Wichita, Kansas

CASING RECORD: Ran 261' of 8 5/8" 32" Smls. Surface Casing. Cemented with 105 sks.
Cement circulated.

Ran 132 jts. of 5 1/2" 15.5# Smls. Casing, set at 4268'. Cemented with 90 sks.

LOG

(Figures indicate bottom of formation — measurements from top of rotary bushing.)

5	Surface Clay	
20	Sand & Gravel	
258	Rdd Bed	3755'
1005	Red Rock, Shale, Gyp & Clay	4125'
1025	Shale, Gyp & Clay	4140'
1200	Salt, Shale & Shells	4155'
2860	Lime & Shale	4170'
3311	Sand, Lime & Shale	4180'
3798	Lime	4195'
3952	Lime & Shale	4200'
3998	Lime	4220'
4127	Lime & Shale	4230'
4270	Mississippi T.D.	4240'
		4250'
		4270'

Circulated for Samples

Slope Tests

500 0°
1500 0°
3000 0°

S. L. M:

2000 OK
3000 OK
3500 OK

RECEIVED
STATE CORPORATION COMMISSION
AUG 13 1970
CONSERVATION DIVISION
Wichita, Kansas

The undersigned, C. W. Sebitts, Attorney-in-Fact for PICKRELL DRILLING COMPANY, hereby certifies in behalf of said Company, that the above is a true and correct log of the formation encountered in drilling the above well as reflected by the Daily Drilling Reports.

PICKRELL DRILLING COMPANY
By [Signature]
Attorney-in-Fact
Partner

STATE OF KANSAS }
COUNTY OF SEDGWICK } ss.:

On this 11th day of August, 1960, before me the undersigned, a Notary Public, in and for

the County and State aforesaid, personally appeared C. W. Sebitts, to me known to be the identical person who subscribed the name of PICKRELL DRILLING COMPANY to the foregoing instrument as its Attorney-in-Fact and acknowledged to me that he executed the same as his free and voluntary act and deed, and as the free and voluntary act and deed of such company, for the uses and purposes therein set forth.

Given under my hand and seal of office the day and year last above written.

My commission expires: September 24, 1962

[Signature]
Notary Public
Maxine Johnson