

MAR 11 1970


WELL PLUGGING RECORD

CONSERVATION DIVISION

Wichita, Kansas KINGMAN

County, Sec 28 Twp. 29 Rge. 6 (E) W (W)

Give All Information Completely Make Required Affidavit Mail or Deliver Report to: Conservation Division State Corporation Commission 212 No. Market Wichita, Kansas

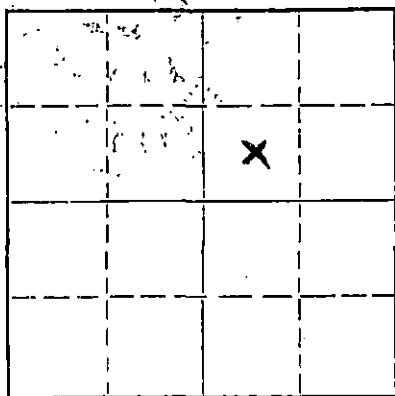

Locate well correctly on above Section Plat

Location as "NE/CNW/SW" or footage from lines C SW NE Lease Owner PICKRELL DRUG CO. WICHITA, KANSAS Lease Name EARLY "D" Well No. Office Address 705 FOURTH NATIONAL BANK BUILDING Character of Well (completed as Oil, Gas or Dry Hole) Oil Date well completed March 17 1969 Application for plugging filed FEBRUARY 19 70 Application for plugging approved FEBRUARY 19 70 Plugging commenced FEBRUARY 24 19 70 Plugging completed FEBRUARY 26 19 70 Reason for abandonment of well or producing formation Depleted

If a producing well is abandoned, date of last production December 15 1969 Was permission obtained from the Conservation Division or its agents before plugging was commenced? YES

Name of Conservation Agent who supervised plugging of this well Russell Biberstein Producing formation Viola - Simpson Depth to top 4510 Bottom 4562 Total Depth of Well 4562 Feet Show depth and thickness of all water, oil and gas formations.

OIL, GAS OR WATER RECORDS

CASING RECORD

Table with 7 columns: FORMATION, CONTENT, FROM, TO, SIZE, PUT IN, PULLED OUT. Row 1: 8 5/8, 218, None. Row 2: 5 1/2, 4561, 3569.

Describe in detail the manner in which the well was plugged, indicating where the mud fluid was placed and the method or methods used in introducing it into the hole. If cement or other plugs were used, state the character of same and depth placed, from feet to feet for each plug set.

February 24, 1970 Plugged off bottom. Dumped sand to 3600'. Mixed and dumped 5 sx of cement.

February 26, 1970 Plugged off top. Set 10' rock bridge from 200' to 210'. Mixed and dumped 25 sx of cement. Mudded casing to 40'. Set 10' rock bridge from 40' to 30'. Mixed and dumped 10 sx of cement from 30' to base of cellar.

(If additional description is necessary, use BACK of this sheet)

Name of Plugging Contractor RUSS CASING PULLING, INC. Address P. O. BOX 1082 GREAT BEND, KANSAS 67530

STATE OF Kansas, COUNTY OF Sedgwick, ss. Dale M. Robinson (employee of owner) or (owner or operator) of the above-described well, being first duly sworn on oath, says: That I have knowledge of the facts, statements, and matters herein contained and the log of the above-described well as filed and that the same are true and correct. So help me God.

(Signature) Dale M. Robinson Dale M. Robinson 705 Fourth National Bank Bldg., Wichita, Kansas (Address)

Subscribed and Sworn to before me this 10th day of March, 1970. Esther Lamone Notary Public.



ROTARY DRILLING LOG

COMPANY: Pickrell Drilling Company
705 Fourth National Bank Bldg.
Wichita, Kansas 67202
LOCATION: Early "D" No. 1
C SW NE Sec. 28-29S-6W
Kingman County, Kansas
CONTRACTOR: **PICKRELL DRILLING COMPANY**
Wichita, Kansas

Rotary Drilling Commenced 2/8/69
Rotary Drilling Completed 2/22/69

CASING RECORD: (12 jts.) 8 5/8" surface casing set at 218' KB cemented with 155 sacks cement, 2% gel. Completed 2:45, Feb. 8, 1969. Circulated.
(143 jts.) J-55, 14.5# 5 1/2" casing set at 4560', 1' off bottom, and cemented with 250 sacks cement, 2% gel. Completed 12:15 AM, Feb. 23, 1969.

LOG

(Figures indicate bottom of formation — measurements from top of rotary bushing.)

50	Sand	<u>C. F. S.</u>
219	Red Rock	3315
1020	Red Bed & Shale	3326
2360	Lime & Shale	3611
2575	Shale & Lime	3630
3135	Lime & Shale	3640
3315	Shale & Lime	3665
3460	Lime	3715
3555	Lime & Shale	3740
3890	Lime	3780
4136	Lime & Shale	3795
4160	Mississippi	4148
4189	Chert	4160
4270	Lime	4175
4340	Lime & Chert	4189
4450	Lime	4495
4494	Shale	4500
4500	Sand	4514
4514	Shale & Lime	4526
4550	Lime	4535
4560	Sand, RTD	4541
		4560

RECEIVED
STATE CORPORATION COMMISSION
FEB 24 1970
CONSERVATION DIVISION
Wichita, Kansas

Slope Tests

2500
3000
3500
4000
4500

S. L. M.

Board	3223.66'
Strap	<u>3220.75'</u>
Correction	2.91' short

The undersigned, C. W. Sebitts, Attorney-in-Fact for PICKRELL DRILLING COMPANY, hereby certifies in behalf of said Company, that the above is a true and correct log of the formation encountered in drilling the above well as reflected by the Daily Drilling Reports.

PICKRELL DRILLING COMPANY

By C. W. Sebitts, Attorney-in-Fact

STATE OF KANSAS }
COUNTY OF SEDGWICK } ss.:

On this 26th day of February, 19 69, before me the undersigned, a Notary Public, in and for the County and State aforesaid, personally appeared C. W. Sebitts, to me known to be the identical person who subscribed the name of PICKRELL DRILLING COMPANY to the foregoing instrument as its Attorney-in-Fact and acknowledged to me that he executed the same as his free and voluntary act and deed, and as the free and voluntary act and deed of such company, for the uses and purposes therein set forth.

Given under my hand and seal of office the day and year last above written.

My commission expires: May 10, 1970

L. M. Whiting
Notary Public
L. M. Whiting