


STATE OF KANSAS
STATE CORPORATION COMMISSION
CONSERVATION DIVISION
P. O. BOX 17027
WICHITA, KANSAS 67217

WELL PLUGGING RECORD

Kingman County, Sec. 28 Twp. 29S Rge. (E) 6 (W)
Location as "NE/CNW/SE" or footage from lines: Approx. C SW SE (610FSL of SE 1/4)
Lease Owner: Petroleum, Inc. (610FWL of SE 1/4)
Lease Name: Early "C"
Office Address: Route 2, Great Bend, Kansas 67530 Well No. 1
Character of Well (completed as Oil, Gas or Dry Hole): oil
Date well completed: 19__
Application for plugging filed: 19__
Application for plugging approved: 19__
Plugging commenced: October 28 1975
Plugging completed: October 31 1975
Reason for abandonment of well or producing formation: depleted

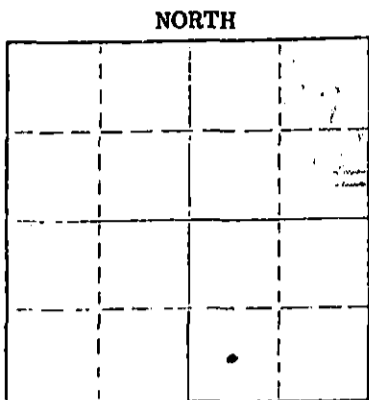

Locate well correctly on above Section Plat

If a producing well is abandoned, date of last production: 19__
Was permission obtained from the Conservation Division or its agents before plugging was commenced? yes

Name of Conservation Agent who supervised plugging of this well: G. R. Biberstein
Producing formation: _____ Depth to top: _____ Bottom: _____ Total Depth of Well: 4560 Feet
Show depth and thickness of all water, oil and gas formations.

OIL, GAS OR WATER RECORDS				CASING RECORD		
FORMATION	CONTENT	FROM	TO	SIZE	PUT IN	PULLED OUT
			248'	8 5/8"	248'	none
			4553'	4 1/2"	4553'	3458.88

Describe in detail the manner in which the well was plugged, indicating where the mud fluid was placed and the method or methods used in introducing it into the hole. If cement or other plugs were used, state the character of same and depth placed, from _____ feet to _____ feet for each plug set.

Sanded back to 4450' and dumped 4 sacks of cement.
Set 10' rock bridge at 300'. Filled hole with 5 yards of ready mix cement.

RECEIVED
STATE CORPORATION COMMISSION

Name of Plugging Contractor: PIPE PULLERS, INC. (If additional description is necessary, use BACK of this sheet) 11-5-75 NOV 5 1975
Address: Box 128, Ellinwood, Kansas 67526 CONSERVATION DIVISION
Wichita, Kansas

STATE OF KANSAS COUNTY OF BARTON ss.
Evelyn Roth (employee of owner) or (owner-operator) of the above-described well, being first duly sworn on oath, says: That I have knowledge of the facts, statements, and matters herein contained and the log of the above-described well as filed and that the same are true and correct. So help me God.

(Signature) Evelyn Roth
Ellinwood, Kansas (Address)

SUBSCRIBED AND SWORN TO before me this 4th day of November, 1975

My commission expires
JENNY CASSELMAN
NOTARY PUBLIC
BARTON COUNTY, KANSAS
MY COMM. EXP. JULY 16, 1978

Jenny Casselman
Notary Public.

WELL LOG

15-095-0001-0000

COMPANY PETROLEUM INCORPORATED

SEC. 28 T. 29S. R. 6W

FARM EARLY "C" NO. 1


LOC. Approx. C-SW SE

TOTAL DEPTH 4560'

COUNTY Kingman Co., Kansas

COMM. July 23, 1960 COMP. August 8, 1960

CONTRACTOR GARVEY DRILLING COMPANY

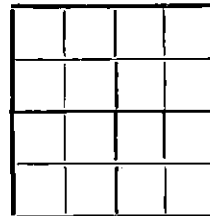

CASING 8-5/8" @ 255' w/200 sax.
4-1/2" @ 4557' w/250 sax.

ELEVATION 1529' DF

PRODUCTION

FIGURES INDICATE BOTTOM OF FORMATIONS

RECEIVED
STATE COMMISSION COMMISSION
NOV 6 1975
CONSERVATION DIVISION
Wichita, Kansas

35	Surface Sand
85	Sand & red bed
256	Red bed & shale
1060	Red bed, shale & shells
2000	Lime & shale
2915	Shale & lime
3633	Lime & shale
3823	Lime
4143	Lime & shale
4410	Lime
4495	Shale & lime
4535	Shale & sand
4560	Simpson sand
4560	T. D.

State of KANSAS }
County of BARTON } ss.

I, R. S. BOYS of GARVEY DRILLING COMPANY

upon oath state that the above and foregoing is a true and correct copy of the log of the #1 EARLY "C" well

Subscribed and sworn to before me this 22nd day of August 1960
R. S. Boys

My Commission Expires: November 12, 1962

Cambridge
NOTARY PUBLIC