


STATE OF KANSAS
STATE CORPORATION COMMISSION

Form CP-4

WELL PLUGGING RECORD

Give All Information Completely
Make Required Affidavit
Mail or Deliver Report to:
Conservation Division
State Corporation Commission
212 No. Market
Wichita, Kansas

NORTH

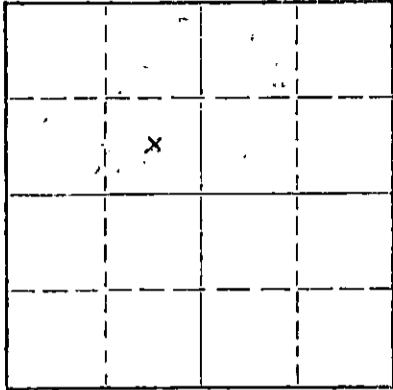

Locate well correctly on above
Section Plat

Kingman County, Sec. 28, Twp. 29S Rge. 6 (E) W (W)

Location as "NE/CNW/SW" or footage from lines C SE NW
Lease Owner Pickrell Drilling Co.
Lease Name McCormick D Well No. 1
Office Address 705 Fourth National Bank Bldg. Wichita, Ks.
Character of Well (completed as Oil, Gas or Dry Hole) dry
Date well completed April 12 19 69
Application for plugging filed 4-14 19 69
Application for plugging approved 4-15 19 69
Plugging commenced 4-15 19 69
Plugging completed 4-18 19 69
Reason for abandonment of well or producing formation Set Pipe didn't make well

If a producing well is abandoned, date of last production 19
Was permission obtained from the Conservation Division or its agents before plugging was commenced? yes

Name of Conservation Agent who supervised plugging of this well Ralph Warren
Producing formation Depth to top Bottom Total Depth of Well 4540 Feet
Show depth and thickness of all water, oil and gas formations.

OIL, GAS OR WATER RECORDS

CASING RECORD

FORMATION	CONTENT	FROM	TO	SIZE	PUT IN	PULLED OUT
				8 5/8	212	none
				4 1/2	4540	3876'

Describe in detail the manner in which the well was plugged, indicating where the mud fluid was placed and the method or methods used in introducing it into the hole. If cement or other plugs were used, state the character of same and depth placed, from feet to feet for each plug set.

Plugged back with sand to 4100'. Mixed and dumped 4 sx of cement from 4100' to 4052'. Pulled casing. Mudded hole to 200'. Set 10' rock bridge from 200' to 190'. Mixed and dumped 25 sx of cement from 190' to 115'. Mudded hole to 40'. Set 10' rock bridge from 40' to 30'. Mixed and dumped 10 sx of cement from 30' to base of cellar.

RECEIVED
STATE CORPORATION COMMISSION
MAY 20 1969
CONSERVATION DIVISION
Wichita, Kansas

Name of Plugging Contractor Russ Casing Pulling, Inc.
Address P.O. Box 1082 Great Bend, Kansas 67530


STATE OF Kansas, COUNTY OF Sedgwick, ss.

(employee of owner) or (owner or operator) of the above-described well, being first duly sworn on oath, says: That I have knowledge of the facts, statements, and matters herein contained and the log of the above-described well as filed and that the same are true and correct. So help me God.

(Signature) [Signature]
705 Fourth National Bank Bldg, Wichita, Kansas
(Address)

Subscribed and sworn to before me this 16th day of May, 19 69

My commission expires May 10, 1970
L.M. Whiting Notary Public.

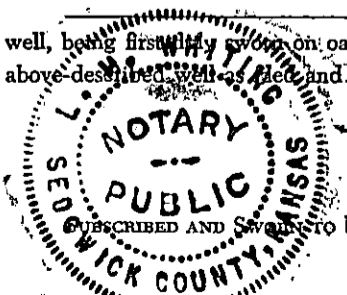

ROTARY DRILLING LOG

COMPANY: Pickrell Drilling Company
705 Fourth National Bank Bldg.
Wichita, Kansas 67202

Rotary Drilling Commenced 3/17/69

Rotary Drilling Completed 3/30/69

LOCATION: McCormick "D" No. 1
C SE NW Sec. 28-29S-6W
Kingman County, Kansas

CONTRACTOR: **PICKRELL DRILLING COMPANY**
Wichita, Kansas

CASING RECORD: (12 jts.) Used 28# 8 5/8" surface casing set at 212' KB with 165 sacks cement. Complete @ 6:00 PM, 3/17/69, circulated.

(139 jts.) J-55 4 1/2" 9.5# casing set at 4540' KB, 6' off bottom, cemented with 150 sacks common cement w/6# Gilsonite per sack. Plug down @ 10:00 PM, 3/29/69.

LOG

(Figures indicate bottom of formation — measurements from top of rotary bushing.)

40	Sand & Red Beds	<u>C. F. S.</u>
228	Red Rock	3305'
610	Red Bed & Shale	3315'
1050	Shale & Shells	3323'
1445	Lime & Shale	3638'
1655	Lime	4145'
1900	Lime & Shale	4500'
3307	Shale & Lime	4507'
3459	Lime	4511'
3545	Lime & Shale	4525'
4130	Lime	4540'
4158	Chert, Miss.	
4200	Miss.	
4302	Lime & Chert	<u>Slope Tests</u>
4375	Chert & Lime	3000'
4410	Lime	3500'
4507	Lime & Sand	4000'
4513	Sand	4500'
4540	Shale, Lime & Chert, RTD	
		<u>S. L. M.</u>
		3953'

RECEIVED
STATE CORPORATION COMMISSION
APR 15 1969
CONSERVATION DIVISION
Wichita, Kansas

The undersigned, C. W. Sebitts, Attorney-in-Fact for PICKRELL DRILLING COMPANY, hereby certifies in behalf of said Company, that the above is a true and correct log of the formation encountered in drilling the above well as reflected by the Daily Drilling Reports.

PICKRELL DRILLING COMPANY

By [Signature]
C. W. Sebitts Attorney-in-Fact

STATE OF KANSAS }
COUNTY OF SEDGWICK } ss.:

On this 7th day of April, 19 69, before me the undersigned, a Notary Public, in and for the County and State aforesaid, personally appeared C. W. Sebitts, to me known to be the identical person who subscribed the name of PICKRELL DRILLING COMPANY to the foregoing instrument as its Attorney-in-Fact and acknowledged to me that he executed the same as his free and voluntary act and deed, and as the free and voluntary act and deed of such company, for the uses and purposes therein set forth.

Given under my hand and seal of office the day and year last above written.

My commission expires: May 10, 1970

[Signature]
Notary Public
L. M. Whiting