

STATE OF KANSAS
STATE CORPORATION COMMISSION

Form CP-4

Give All Information Completely
Make Required Affidavit
Mail or Deliver Report to:
Conservation Division
State Corporation Commission
212 No. Market
Wichita, Kansas 67202

WELL PLUGGING RECORD

Kingman County, Sec. 28 Twp. 29S Rge. ~~XXX~~ 6 (W)

Location as "NE/CNW%SW%" or footage from lines 400' from S, Line & 660' from W, Line of the NE 1/4

Lease Owner Pickrell Drilling Company

Lease Name Early "D" Well No. 2

Office Address 705 Fourth National Bank, Wichita, Kansas

Character of Well (completed as Oil, Gas or Dry Hole) Dry Hole

Date well completed May 21 1970

Application for plugging filed May 21 1970

Application for plugging approved May 21 1970


Plugging commenced May 21 1970

Plugging completed May 21 1970

Reason for abandonment of well or producing formation Dry Hole

If a producing well is abandoned, date of last production 19

Was permission obtained from the Conservation Division or its agents before plugging was commenced? Yes

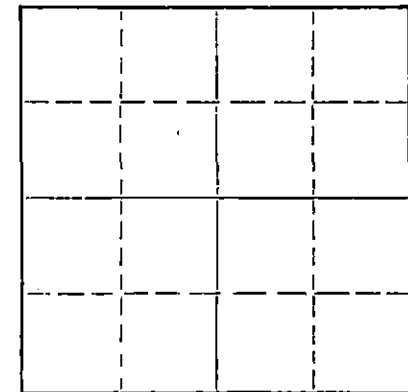

Locate well correctly on above Section Plat

Name of Conservation Agent who supervised plugging of this well Archie V. Elving

Producing formation Depth to top Bottom Total Depth of Well 450 Feet

Show depth and thickness of all water, oil and gas formations.

OIL, GAS OR WATER RECORDS

CASING RECORD

FORMATION	CONTENT	FROM	TO	SIZE	PUT IN	PULLED OUT
				8-5/8"	214	None

Describe in detail the manner in which the well was plugged, indicating where the mud fluid was placed and the method or methods used in introducing it into the hole. If cement or other plugs were used, state the character of same and depth placed, from feet to feet for each plug set.

Plug # 1 @ 205 w/1/2 sack hulls, 25 sacks cement,
Plug # 2 @ 40' w/10 sacks cement

RECEIVED
STATE CORPORATION COMMISSION
MAY 28 1970
CONSERVATION DIVISION
Wichita, Kansas

(If additional description is necessary, use BACK of this sheet)

Name of Plugging Contractor Pickrell Drilling Company


Address 705 Fourth National Bank Building, Wichita, Kansas 67202

STATE OF Kansas, COUNTY OF Sedgwick, ss.

C. W. Sebitts (employee of owner) or (owner or operator) of the above-described well, being first duly sworn on oath, says: That I have knowledge of the facts, statements, and matters herein contained and the log of the above-described well as filed and that the same are true and correct. So help me God.

(Signature) C. W. Sebitts
705 Fourth National Bank Bldg, Wichita, Kansas
(Address)

Subscribed and sworn to before me this 26th day of May, 1970

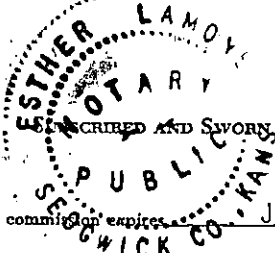

Esther Lamone
Notary Public.

My commission expires January 19, 1973

ROTARY DRILLING LOG

COMPANY: Pickrell Drilling Company
705 Fourth National Bank Bldg.
Wichita, Kansas 67202

Rotary Drilling Commenced 5/9/70

Rotary Drilling Completed 5/21/70

LOCATION: Early "D" No. 2, 400' from South line & 660' from West Line of NE/4,
Section 28-29S-6W, Kingman County, Kansas

CONTRACTOR: **PICKRELL DRILLING COMPANY**
Wichita, Kansas

CASING RECORD: Ran 11 Jts. 8-5/8" surface casing set at 214' K/B. Cemented with
165 sacks. Completed 1:00 P.M. May 9, 1970. Circulated.

No oil string run. D & A, Plugged 10:30 P.M. May 21, 1970.

LOG

(Figures indicate bottom of formation — measurements from top of rotary bushing.)

55	Sand		C. F. S.
214	Red Rock etc.		4493
385	Red Bed & Shale		4497
1430	Shale & Lime		4501
1605	Lime & Shale		
1805	Shale & Lime		
2010	Lime & Shale		S. L. M.
2246	Shale & Lime	Strap	4331.40
2384	Lime & Shale	Board	4331.40
2845	Shale		00
3375	Shale & Lime		
3655	Lime & Shale		Slope Tests
3695	Shale & Lime		2000
3795	Lime & Shale		2500
4199	Lime		3000
4305	Lime & Shale		3500
4405	Lime		4000
4491	Lime & Shale		4500
4495	Shale		
4497	Misener (Sand)		
4501	Sand, RTD		

STATE RECEIVED
CONSERVATION COMMISSION
MAY 28 1970
WICHITA, KANSAS

The undersigned, C. W. Sebitts, Attorney-in-Fact for PICKRELL DRILLING COMPANY, hereby certifies in behalf of said Company, that the above is a true and correct log of the formation encountered in drilling the above well as reflected by the Daily Drilling Reports.

PICKRELL DRILLING COMPANY

By C. W. Sebitts Attorney-in-Fact

STATE OF KANSAS }
COUNTY OF SEDGWICK } ss.:

On this 26th day of May, 19 70, before me the undersigned, a Notary Public, in and for the County and State aforesaid, personally appeared C. W. Sebitts, to me known to be the identical person who subscribed the name of PICKRELL DRILLING COMPANY to the foregoing instrument as its Attorney-in-Fact and acknowledged to me that he executed the same as his free and voluntary act and deed, and as the free and voluntary act and deed of such company, for the uses and purposes therein set forth.

Given under my hand and seal of office the day and year last above written.

My commission expires: January 19, 1973

Esther Lamone
Esther Lamone Notary Public

