

STATE OF KANSAS  
STATE CORPORATION COMMISSION


Form CP-4

Give All Information Completely  
Make Required Affidavit  
Mail or Deliver Report to:  
Conservation Division  
State Corporation Commission  
212 No. Market  
Wichita, Kansas 67202

WELL PLUGGING RECORD

KINGMAN County, Sec. 28 Twp. 29 Rge. (E)6 (W)  
Location as "NE/CNW/SW" or footage from lines. SW NE SE  
Lease Owner SANTA-FE PIPE & SUPPLY, INC.  
Lease Name PORT EARLY (SWDW) Well No. 2  
Office Address BOX 562 - GREAT BEND, KANSAS 67530  
Character of Well (completed as Oil, Gas or Dry Hole) S.W.D.  
Date well completed MARCH 17 19 70  
Application for plugging filed MAY 19 19 71  
Application for plugging approved MAY 20 19 71  
Plugging commenced MAY 20 19 71  
Plugging completed JUNE 10 19 71  
Reason for abandonment of well or producing formation LEASE WAS DEPLETED

If a producing well is abandoned, date of last production \_\_\_\_\_ 19 \_\_\_\_  
Was permission obtained from the Conservation Division or its agents before plugging was commenced? YES

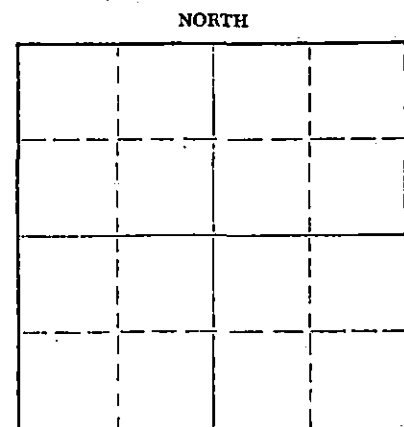

Locate well correctly on above Section Plat

Name of Conservation Agent who supervised plugging of this well G. RUSSELL BIBERSTEIN  
Producing formation \_\_\_\_\_ Depth to top \_\_\_\_\_ Bottom \_\_\_\_\_ Total Depth of Well 4800' Feet  
Show depth and thickness of all water, oil and gas formations.

OIL, GAS OR WATER RECORDS

CASING RECORD

FORMATION	CONTENT	FROM	TO	SIZE	PUT IN	PULLED OUT
				9 5/8"	258'	NONE
				5 1/2"	4502'	2820, 15'

Describe in detail the manner in which the well was plugged, indicating where the mud fluid was placed and the method or methods used in introducing it into the hole. If cement or other plugs were used, state the character of same and depth placed, from \_\_\_\_\_ feet to \_\_\_\_\_ feet for each plug set.

4800' - 4427' - PLUG  
 4427' - 4415' - SAND  
 4415' - 4375' - 5 SACKS CEMENT  
 4375' - 240' - MUD  
 240' - 230' - ROCK BRIDGE  
 230' - BASE - DUMPED 5 YARDS OF READY MIX

RECEIVED  
STATE CORPORATION COMMISSION  
AUG 9 1971  
CONSERVATION DIVISION  
Wichita, Kansas

(If additional description is necessary, use BACK of this sheet)  
Name of Plugging Contractor SANTA-FE PIPE & SUPPLY, INC.  
Address BOX 562 - GREAT BEND, KANSAS 67530

STATE OF KANSAS, COUNTY OF BARTON, ss.  
T. L. NUTT ~~XXXXXXXXXXXXX~~ or (owner or operator) of the above-described well, being first duly sworn on oath, says: That I have knowledge of the facts, statements, and matters herein contained and the log of the above-described well as filed and that the same are true and correct. So help me God.

(Signature) [Signature]  
BOX 562 - GREAT BEND, KANSAS 67530  
(Address)

SUBSCRIBED AND SWORN to before me this 4th day of August 19 71

My commission expires

July 31, 1974

Mary M. Guesnier  
Notary Public.

*Well Log*

GABBERT-JONES, INC.  
WICHITA, KANSAS  
DRILLERS' WELL LOG

PORT EARLY #2 (OWWO)  
SW NE SE Section 28-29S-6W  
Kingman County, Kansas

OPERATOR - Tenneco Oil Company

Old Information: Commence May 12, 1969, Completed May 22, 1969. 8-5/8" casing @ 258'  
w/180 sacks cement, 5-1/2" casing @ 4502' w/150 sacks cement.  
TD 4510. Temporarily abandoned.

New Information: Commenced: March 7, 1970  
Completed: March 17, 1970

DEPTH		FORMATION	REMARKS
From	To		
4510	4548	Shale	
4548	4602	Simpson	
4602	4635	Lime and sand	
4635	4800	Arbuckle lime	
4800	TD		Ran 369' of 4" liner.

RECEIVED  
STATE CORPORATION COMMISSION  
MAY 20 1971  
CONSERVATION DIVISION  
Wichita, Kansas

I, E. E. HALL, certify this is a correct copy of the Drillers' Log for the well washed down in the SW NE SE Section 28-29S-6W, Kingman County, Kansas, to the best of my knowledge and belief.

*E. E. Hall*

E. E. HALL

STATE OF KANSAS )  
                          ) SS.  
COUNTY OF SEDGWICK )

Before me, the undersigned, a Notary Public within and for said County and State, on this 23 day of March, 1970, personally appeared E. E. Hall to me personally known to be the identical person who executed the within and foregoing instrument and acknowledged to me that he executed the same as his free and voluntary act and deed for the uses and purposes therein set forth.

IN WITNESS WHEREOF, I have hereunto set my hand and official seal the day and year last above written.

My Commission Expires Feb. 1, 1972.

*Barbara J. Layton*  
Barbara J. Layton, Notary Public

