

15-095-00356-0000

STATE OF KANSAS
STATE CORPORATION COMMISSION


WELL PLUGGING RECORD

Give All Information Completely
Make Required Affidavit
Well or Deliver Report to:
Conservation Division
State Corporation Commission
211 No. Broadway
Wichita, Kansas

Kingman County. Sec. 4 Twp. 29 Rge. - (E) 7 (W)

Location as "NE/CNW/SW" or footage from lines NW NW SE
Lease Owner Sunray Mid-Continent Oil Company
Lease Name Bertha Voth Well No. 1
Office Address Box 1878 - Wichita, Kansas
Character of Well (completed as Oil, Gas or Dry Hole) Dry Hole
Date well completed October 5, 19 59
Application for plugging filed October 6, 19 59
Application for plugging approved October 7, 19 59
Plugging commenced October 7, 19 59
Plugging completed October 12, 19 59
Reason for abandonment of well or producing formation Dry Hole

NORTH

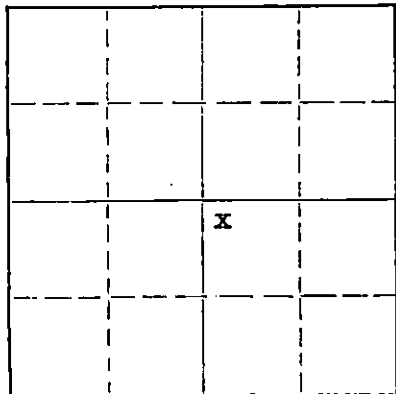

Locate well correctly on above
Section Plat

If a producing well is abandoned, date of last production --- 19 ---
Was permission obtained from the Conservation Division or its agents before plugging was commenced? Yes

Name of Conservation Agent who supervised plugging of this well Fred W. Hampel
Producing formation None Depth to top --- Bottom --- Total Depth of Well 4467' Feet
Show depth and thickness of all water, oil and gas formations.

OIL, GAS OR WATER RECORDS

CASING RECORD

FORMATION	CONTENT	FROM	TO	SIZE	PUT IN	PULLED OUT
Mississippi	Water	4075'	4090	8-5/8"	363	0

Describe in detail the manner in which the well was plugged, indicating where the mud fluid was placed and the method or methods used in introducing it into the hole. If cement or other plugs were used, state the character of same and depth placed, from --- feet to --- feet for each plug set.

Filled hole w/ drilling mud and kept hole full until settling stopped.
Ten sack cement plug placed at the surface. Steel Plate welded over surface pipe.

RECEIVED
STATE CORPORATION COMMISSION

OCT 13 1959

CONSERVATION DIVISION
WICHITA, KANSAS

(If additional description is necessary, use BACK of this sheet)

Name of Plugging Contractor Stickle Drilling Company
Address Tulsa, Oklahoma

STATE OF Kansas, COUNTY OF Sedgwick, ss.
Nash A. Gough (employee of owner) or (owner or operator) of the above-described well, being first duly sworn on oath, says: That I have knowledge of the facts, statements, and matters herein contained and the log of the above-described well as filed and that the same are true and correct. So help me God.

(Signature) Nash A. Gough
Box 1878 - Wichita, Kansas
(Address)

SUBSCRIBED AND SWORN to before me this 12 day of October, 19 59

My commission expires July 13, 1963

[Signature]
Notary Public.

Sunray Mid-Continent Oil Company
Tulsa, Oklahoma

Tulsa, Oklahoma
October 6, 1959

CONTRACTOR: Stickle Drilling Company
Drilling Commenced: September 19, 1959
Drilling Completed: October 4, 1959


Bertha Voth #1 NW/4
NW/4 SE/4 Sec. 4-29S-
7W, Kingman Co., Kansas

DRILLERS LOG

Depth Figures Indicate Base of Formation:

Surface	0
Sand	120
Shale	150
Red Bed & Sand	220
Red Bed & Shale	550
Shale	975
Salt & Shale	1082
Lime & Shale	1805
Lime	2000
Shale & Lime	3350
Lime & Shale	3615
Lime	3743
Lime & Shale	4075
Chat	4090
Mississippi Chat	4110
Lime	4116
Lime Chert & Shale	4180
Lime & Shale	4290
Lime Shale & Chert	4317
Shale & Lime	4333
Lime & Shale	4435
Lime	4451
Lime & Shale	4456
Lime	4491 TD

I, Fred E. Stickle hereby certify the above to be a true and complete Drillers Log of Sunray Mid-Continent Oil Company's Bertha Voth #1 NW/4 NW/4 SE/4 Section 4-29S-7W, Kingman County, Kansas.


Fred E. Stickle


Notary Public

February 13, 1960
My Commission Expires