


STATE OF KANSAS
STATE CORPORATION COMMISSION
200 Colorado Derby Bldg.
Wichita, Kansas 67202

Form CP-4
Rev. 12-15-80

WELL PLUGGING RECORD

Give All Information Completely
Make Required Affidavit

COUNTY Kingman SEC. 5 TWP. 29S RGE. 7W E/W
Location as in quarters or footage from lines:
150' SE of C SW SE

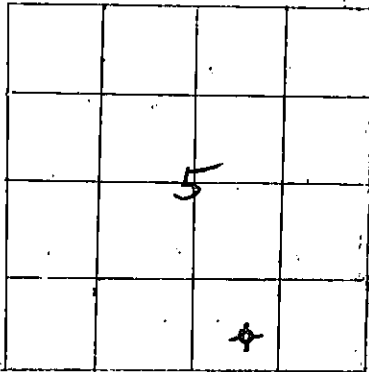

Lease Owner Kansas Petroleum, Inc.
Lease Name Woodson Well No. 41
Office Address 200 E. First, Suite 100, Wichita, Kansas 67202
Character of Well (Completed as Oil, Gas or Dry Hole): Dry Hole
Date Well Completed March 8, 1983
Application for plugging filed March 18, 1983
Plugging commenced 3-8-83
Plugging completed 3-8-83
Reason for abandonment of well or producing formation Dry Hole

Locate Well
correctly on above
Section Platt.

Was permission obtained from the Conservation Division or it's
Agent's before plugging was commenced? Yes

Name of Conservation Agent who supervised plugging of this well Maurice V. Leslie
Producing formation _____ Depth to top _____ bottom _____ T.D. 4526'
Show depth and thickness of all water, oil and gas formations.

OIL, GAS OR WATER RECORDS

Casing Record

Formation	Content	From	To	Size	Put in	Pulled Out
		0'	329'	8-5/8"	322.85'	None

Describe in detail the manner in which the well was plugged, indicating where the mud
fluid was placed and the method or methods used in introducing it into the hold. If cement
or other plugs were used, state the character of same and depth placed, from _____ feet
to _____ feet for each plug set.

Plugged with 40 sacks cement at 1000';
40 sacks cement at 350'; 12 sacks cement
and bridge plug at 40'; 10 sacks cement in
rat hole; and 10 sacks cement in mouse hole.

(If additional description is necessary, use BACK of this sheet)

Name of Plugging Contractor Halliburton Cementing Co.

STATE OF KANSAS COUNTY OF SEDGWICK, ss.
John D. Knightley, Agent (employee of owner) or (owner or operator) of the
above-described well, being first duly sworn on oath, says: That I have knowledge of the
facts, statements, and matters herein contained and the log of the above-described well as
filed and that the same are true and correct. So help me God.

(Signature) [Signature]
221 S. Broadway, Wichita, Kansas 67202
(Address)

SUBSCRIBED AND SWORN TO before me this 18th day of March, 19 83


[Signature]
Notary Public.

My Commission expires: March 12, 1987

RECEIVED
STATE CORPORATION COMMISSION

APR 01 1983

CONSERVATION DIVISION
Wichita, Kansas

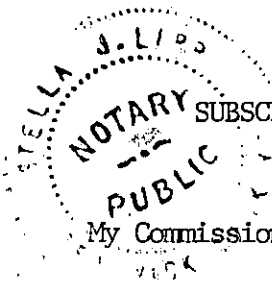

Kansas Petroleum, Inc.
200 E. First, Suite 100
Wichita, Kansas 67202

-

Woodson #1
150' SE of C SW SE
Sec. 5-29S-7W
Kingman County, Kansas

Contractor: D. R. Lauck Oil Company, Inc.
221 S. Broadway, Suite 400
Wichita, Kansas 67202

Commenced: February 26, 1983
Completed: March 8, 1983

Drillers Log

Clay & Sand	130
Shale & Red Bed	335
Red Bed & Shale	980
Shale & Shells	1630
Shale	2875
Shale & Lime	3140
Lime & Shale	3170
Shale & Lime	3200
Lime & Shale	3650
Lime	4128
Chert	4153
Lime	4526 RTD

Casing: 329' 8-5/8" cemented with 225 sacks common cement,
2% Gel, 3% Calcium Chloride.