

15-095-20116-0000

STATE OF KANSAS  
STATE CORPORATION COMMISSION

Form CP-4

WELL PLUGGING RECORD

Give All Information Completely  
Make Required Affidavit  
Mail or Deliver Report to:  
Conservation Division  
State Corporation Commission  
212 No. Market  
Wichita, Kansas

Kingman County. Sec. 14 Twp. 29S Rge. 7W (E) (W)

Location as "NE/CNW/SW" or footage from lines SW NE SW

Lease Owner H. B. Mabee Company

Lease Name Whitelaw Well No. 1

Office Address 1129 S.E. 29th, Oklahoma City, Okla.

Character of Well (completed as Oil, Gas or Dry Hole) Dry Hole

Date well completed Sept. 12 1968

Application for plugging filed Sept. 12 1968

Application for plugging approved Sept. 12 1968


Plugging commenced Sept. 12 1968

Plugging completed Sept. 12 1968

Reason for abandonment of well or producing formation No commercial quantities of oil or gas encountered.

If a producing well is abandoned, date of last production 19

Was permission obtained from the Conservation Division or its agents before plugging was commenced? Yes

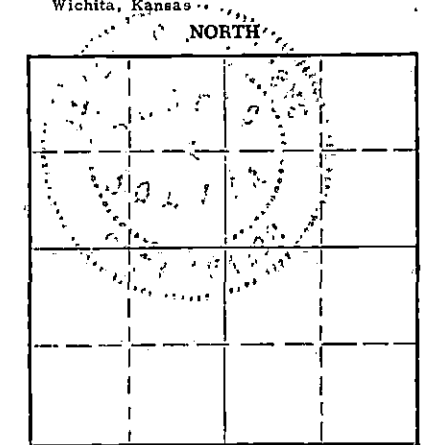

Locate well correctly on above Section Plat

Name of Conservation Agent who supervised plugging of this well Ralph Warren

Producing formation \_\_\_\_\_ Depth to top \_\_\_\_\_ Bottom \_\_\_\_\_ Total Depth of Well 4488 Feet

Show depth and thickness of all water, oil and gas formations.

OIL, GAS OR WATER RECORDS

CASING RECORD

FORMATION	CONTENT	FROM	TO	SIZE	PUT IN	PULLED OUT
Surface Hole		Surface	203'	8-5/8"		Left in.

Describe in detail the manner in which the well was plugged, indicating where the mud fluid was placed and the method or methods used in introducing it into the hole. If cement or other plugs were used, state the character of same and depth placed, from \_\_\_\_\_ feet to \_\_\_\_\_ feet for each plug set.

Plug at 200', 25 sx cement, 1/2 sack hulls;  
Mud to 40', plug, 10 sx cement, 1/2 sack hulls;  
2 sacks cement in rat hole.

RECEIVED  
STATE CORPORATION COMMISSION  
SEP 18 1968  
CONSERVATION DIVISION  
Wichita, Kansas

(If additional description is necessary, use BACK of this sheet)

Name of Plugging Contractor Donelson Drilling Company  
Address 619 First National Building, Wichita, Kansas 67202


STATE OF KANSAS, COUNTY OF \_\_\_\_\_, ss.

James L. Donelson (employee of owner) or (owner or operator) of the above-described well, being first duly sworn on oath, says: That I have knowledge of the facts, statements, and matters herein contained and the log of the above-described well as filed and that the same are true and correct. So help me God.

(Signature) James L. Donelson

619 First Nat'l Bk Bldg., Wichita, Ks. (Address)

SUBSCRIBED AND SWORN to before me this 17th day of September, 1968

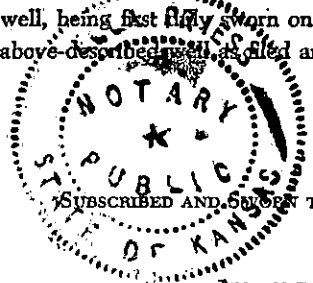

Ella Priess, Notary Public.

My commission expires August 25, 1972

DRILLERS LOG

H. B. Mabee Company  
Whitelaw #1  
SW NE SW, Sec. 14-29-7W  
Kingman County, Kansas

Elevation: 1570 GL, 1580 KB

Total Depth: 4488'

Surface Casing Record:  
Ran 203' of 8-5/8" cemented  
w/225 sx cement, 2% chloride  
on 9-1-68.

Contractor: Donelson Drilling Company

Commenced: 8-31-68

Completed: 9-12-68

<u>Formation</u>	<u>Depth</u>
Surface Hole	203'
Lime	305'
Red Bed	450'
Shale	1080'
Lime & Shale	2023'
Shale & Lime	2580'
Lime & Shale	3385'
Lime	4026'
Lime & Shale	4111'
Lime	4366'
Lime & Shale	4488' T.D.

RECEIVED  
STATE CORPORATION COMMISSION  
SEP 18 1968  
CONSERVATION DIVISION  
Wichita, Kansas

I hereby certify that the foregoing statements are true and correct to the best of my knowledge and belief.

DONELSON DRILLING COMPANY

*James L. Donelson*  
James L. Donelson

STATE OF KANSAS: ss:

Subscribed and sworn to before me, a Notary Public in and for said State, this 16th day of September, 1968.

*Ella Priess*  
Ella Priess, Notary Public

My Commission Expires:  
August 25, 1972

