


WELL PLUGGING RECORD

Give All Information Completely
Make Required Affidavit
Mail or Deliver Report to:
Conservation Division
State Corporation Commission
211 No. Broadway
Wichita, Kansas

Stevens County, Sec. 24 Twp. 32 Rge. (E) 39 (W)

NORTH

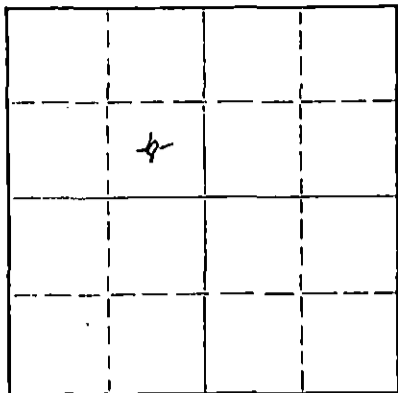

Locate well correctly on above
Section Plat

Location as "NE/CNW/SW" or footage from lines C. SE NW
Lease Owner Panhandle Eastern Pipe Line Company
Lease Name Youngren Well No. 1
Office Address P. O. Box 979, Liberal, Kansas
Character of Well (completed as Oil, Gas or Dry Hole) Gas
Date well completed October 15 1960
Application for plugging filed November 7 1961
Application for plugging approved November 14 1961
Plugging commenced December 5 1961
Plugging completed December 6 1961
Reason for abandonment of well or producing formation non-economical

If a producing well is abandoned, date of last production September 1961
Was permission obtained from the Conservation Division or its agents before plugging was commenced? Yes

Name of Conservation Agent who supervised plugging of this well W. L. Lackamp
Producing formation Hugoton Depth to top 2290 Bottom 2350 Total Depth of Well 2749 Feet
Show depth and thickness of all water, oil and gas formations. PBTD 2664

OIL, GAS OR WATER RECORDS

CASING RECORD

FORMATION	CONTENT	FROM	TO	SIZE	PUT IN	PULLED OUT
				10"	376	
				12 1/2	570	
				6 5/8	1100	
				5 3/16	2437	1064'

Describe in detail the manner in which the well was plugged, indicating where the mud fluid was placed and the method or methods used in introducing it into the hole. If cement or other plugs were used, state the character of same and depth placed, from _____ feet to _____ feet for each plug set.

Set cement retainer at 2759' and squeezed off gas zone with 190 sacks, and dumped 10 sacks on top of retainer, then cemented with 10 sacks at 1320'. Put in a 30' rock bridge and cemented with 35 sacks at 565'. Cemented with 15 sacks from 30' below surface to 8' of surface then capped with 10 sacks.

RECEIVED
STATE CORPORATION COMMISSION

12-13-61 DEC 13 1961

CONSERVATION DIVISION
Wichita, Kansas

(If additional description is necessary, use BACK of this sheet)

Name of Plugging Contractor Knight Casing Pulling Crews
Address Chase, Kansas

STATE OF Kansas, COUNTY OF Stevens, ss.
S. H. Neithercoat (employee of owner) or (~~owner or operator~~) of the above-described well, being first duly sworn on oath, says: That I have knowledge of the facts, statements, and matters herein contained and the log of the above-described well as filed and that the same are true and correct. So help me God.

(Signature) S. H. Neithercoat
S. H. Neithercoat, Area Supt.
P. O. Box 979, Liberal, Kansas
(Address)

SUBSCRIBED AND SWORN TO before me this 11th day of December, 1961

Ronald L. Vanquason
Notary Public.

My commission expires _____
MY COMMISSION EXPIRES SEPT, 29, 1964



