

API NUMBER 15-095-21,486

LEASE NAME Komarek

WELL NUMBER A-3

SPOT LOCATION NW-NE

SEC. 14 TWP. 29 SRGE. 10 COR. (W)

COUNTY Kingman

Date Well Completed _____

Plugging Commenced 9/14/86

Plugging Completed 9/19/86

SEP 24 1986

TYPE OR PRINT
NOTICE: Fill out completely
and return to Cons. Div.
office within 30 days.

CONSERVATION DIVISION

LEASE OPERATOR Wichita, Kansas Beckrell Drilling Co.

ADDRESS 110 N. Market, Suite 205, Wichita, KS 67202

PHONE # (316) 262-8427 OPERATORS LICENSE NO. 5123

Character of Well Gas
(Oil, Gas, D&A, SWD, Input, Water Supply, Well)

Did you notify the KCC/KDHE Joint District Office prior to plugging this well? yes

Which KCC/KDHE Joint Office did you notify? Wichita, KS Don Thompson

Is ACO-1 filed? yes If not, is well log attached? yes

Producing formation _____ Depth to top _____ bottom _____ T.D. 2600

Show depth and thickness of all water, oil and gas formations.

OIL, GAS OR WATER RECORDS | CASING RECORD

Formation	Content	From	To	Size	Put In	Pulled out
				8 5/8	221	None
				4 1/2	2599	1833

Describe in detail the manner in which the well was plugged, indicating where the mud fluid was placed and the method or methods used in introducing it into the hole. If cement or other plugs were used state, the character of same and depth placed, from feet to feet each set. CIB set 2465, 5sx cement with dump bailer Allied pump in 3sx hulls, 15sx jell, 80sx cement, 8 5/8 plug, 20sx cement.

Pluger, Aumiller and Mark Morgenstern on location.
(If additional description is necessary, use BACK of this form.)

Name of Plugging Contractor Clarke Corp. License No. 5105
Address P.O. Box 187, Medicine Lodge, KS 67104

STATE OF Kansas COUNTY OF Barber, ss.

Elmo Morgenstern (employee of operator) or (operator) of above-described well, being first duly sworn on oath, says: That I have knowledge of the facts, statements, and matters herein contained and the log of the above-described well as filed that the same are true and correct, so help me God.

(Signature) Elmo Morgenstern

(Address) Medicine Lodge, KS 67104

State of Kansas - Notary Public

GLEND A MORRISON

SUBSCRIBED AND SWORN TO before me this 22 day of September, 1986

My Appt. Exp. 5-9-90

Glenda Morrison
Notary Public

My Commission expires: May 9, 1990

New Completion Workover

15-095-21486-0000

Oil Company _____

Well No. A-3

Field Komarek


Lease Komarek

Company Man _____

Date Drilled 9/84

County Kingman

State Kansas

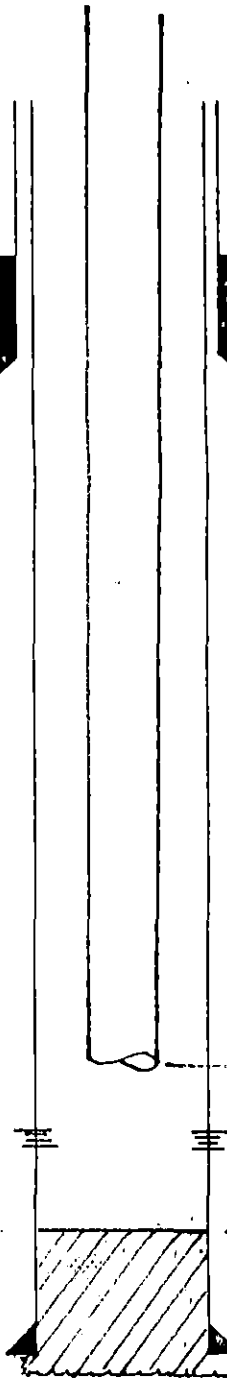

221 Base 8 5/8" w/165 Sx

2519 Base 2 3/8" EDE Tbg. Open Ended

2522-2525 (Indian Cave Perfs)

2535 PBTD (Loggers)

2599 Base 4 1/2" 10.5" SE w/125 Sx Comm. 10% SS + S# Gilsomite / S# 2600 RTD

REMARKS: _____

IVED
SOLUTIONS

5 1985