


STATE OF KANSAS
STATE CORPORATION COMMISSION

Give All Information Completely
Make Required Affidavit
Mail or Deliver Report to:
Conservation Division
State Corporation Commission
311 No. Broadway
Wichita, Kansas

WELL PLUGGING RECORD

KINGMAN County, Sec. 20 Twp. 29 Rge. (E) 10 (W)
Location as "NE/CNW/SE/SW" or footage from lines SE SE SE
Lease Owner TIME PETROLEUM CO.
Lease Name TULYMAN Well No. 1
Office Address 560 FOURTH NATIONAL BANK BLDG WICHITA
Character of Well (completed as Oil, Gas or Dry Hole) DRY HOLE
Date well completed 6-6 1961
Application for plugging filed 6-6 1961
Application for plugging approved 6-6 1961
Plugging commenced 6-6 1961
Plugging completed 6-6 1961
Reason for abandonment of well or producing formation D+A

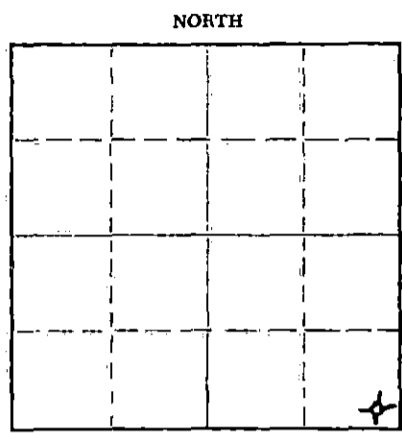

Locate well correctly on above Section Plat

If a producing well is abandoned, date of last production 19
Was permission obtained from the Conservation Division or its agents before plugging was commenced? YES

Name of Conservation Agent who supervised plugging of this well FRED HAMPEL
Producing formation _____ Depth to top _____ Bottom _____ Total Depth of Well 4665 Feet
Show depth and thickness of all water, oil and gas formations.

OIL, GAS OR WATER RECORDS

CASING RECORD

FORMATION	CONTENT	FROM	TO	SIZE	PUT IN	PULLED OUT
<u>Surface hole</u>	<u>fresh water</u>	<u>0</u>	<u>268</u>	<u>8 5/8</u>	<u>260ft</u>	<u>left in cement</u>

Describe in detail the manner in which the well was plugged, indicating where the mud fluid was placed and the method or methods used in introducing it into the hole. If cement or other plugs were used, state the character of same and depth placed, from _____ feet to _____ feet for each plug set.

Plugged at 240' with 1/4 sack Hulla and 15 sacks of Cement; Plug at 35' with 1/4 sack of Hulla and 10 sacks of Cement Plug down at 11:45AM June 6, 1961

2-14-63

(If additional description is necessary, use BACK of this sheet)

Name of Plugging Contractor STRATA DRILLING INC
Address PO Box 355 GREAT BEND KANSAS

STATE OF KANSAS, COUNTY OF SEDGWICK, ss.
OPERATOR (employee of owner) or (owner or operator) of the above-described well, being first duly sworn on oath, says: That I have knowledge of the facts, statements, and matters herein contained and the log of the above-described well as filed and that the same are true and correct. So help me God. TIME PETROLEUM CO.

(Signature) by R. C. Low
WICHITA KANSAS
(Address)

SUBSCRIBED AND SWORN TO before me this 7th day of November, 1962
Lorraine Shullcutt

My commission expires June 1, 1964

Notary Public.

D R I L L E R S L O G#1 Twyman

CASING RECORD: 259.74' of used 8-5/8" surface casing
 COMPANY: Time Petroleum Company
 DESCRIPTION: SE SE SE Section 20-29-10W Kingman County, Kansas
 CONTRACTOR: Strata Drilling, Inc.
 TOTAL DEPTH: 4665'
 COMMENCED: May 25, 1961
 COMPLETED: June 6, 1961

D. & A.

<u>FORMATION</u>	<u>FROM</u>	<u>TO</u>	<u>REMARKS</u>
Surface Clay	0	268	Ran 259.74' (13 Jts.) of used 8-5/8" surface casing; set and cemented at 267.24' with 200 sacks of HA5. Did not circ. cement. Re-cement through 1" pipe with 42 sacks of cement. Job completed at 2:30 A. M. 5-26-61.
Shale	268	1560	
Shale & Lime	1560	3730	
Shale	3730	3743	
Kansas City Lime	3743	3785	
Lime	3785	4143	
Lime & Shale	4143	4296	
Mississippi Chert	4296	4315	
Chert	4315	4325	
Chert, Lime & Shale	4325	4352	
Shale	4352	4558	
Lime & Chert	4558	4566	
Shale & Lime	4566	4596	
Lime	4596	4620	
Lime & Shale	4620	4665	

Total Depth 4665'

D. & A. Plugged.

Plugged as follows: Plugged at 240' with $\frac{1}{4}$ sack hulls and 15 sacks of cement; plug at 35' with $\frac{1}{4}$ sack of hulls and 10 sacks of cement. Plug down at 11:45 A. M. June 6, 1961.

STATE OF KANSAS)
) ss.
 COUNTY OF BARTON)

I certify that this is a true and correct copy of the above log to the best of my knowledge.

STRATA DRILLING, INC.

Jim B. McWilliams
 Jim B. McWilliams, Secy-Treas.

Subscribed and sworn to before me this 6th day of June, 1961.

Elaine H. Taylor
 Elaine H. Taylor, Notary Public

My Commission Expires:
 December 14, 1961