


STATE OF KANSAS
STATE CORPORATION COMMISSION

Give All Information Completely
Make Required Affidavit
Mail or Deliver Report to
Conservation Division
State Corporation Commission
245 North Water
Wichita, KS 67202

FORM CP-4

WELL PLUGGING RECORD

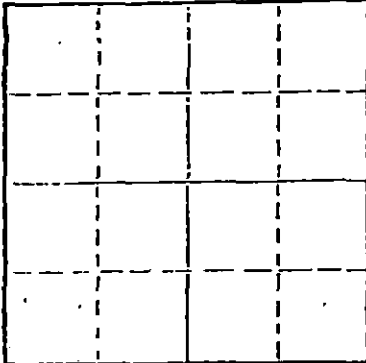

Locate well correctly on above
Section Plat

Kingman County, Sec. 21 Twp. 29S Rge. 10W (X) (W)
Location as "NE/CNW/SE" or footage from lines SE NW SE
Lease Owner The National Oil Company
Lease Name Simon Well No. 1
Office Address Suite 550 O.W. Garvey Building Wichita, KS
Character of Well (completed as Oil, Gas or Dry Hole) dry hole 67530
Date well completed February 23, 1976
Application for plugging filed verbal application 1976
Application for plugging approved verbal approval 1976
Plugging commenced February 23, 1976
Plugging completed February 23, 1976
Reason for abandonment of well or producing formation
If a producing well is abandoned, date of last production 1976
Was permission obtained from the Conservation Division or its agents before plugging was commenced? yes

Name of Conservation Agent who supervised plugging of this well G.R. Biberstein
Producing formation Depth to top Bottom Total Depth of Well 4,665 feet
Show depth and thickness of all water, oil and gas formations.

OIL, GAS OR WATER RECORDS

CASING RECORD

STATE CORP. COMMISSION	CONTENT	FROM	TO	SIZE	PUT IN	PULLED OUT
FEH 27 1976				8 5/8"	345'	none
CONSERVATION DIVISION Wichita, Kansas						

Describe in detail the manner in which the well was plugged, indicating where the mud fluid was placed and the method or methods used in introducing it into the hole. If cement or other plugs were used, state the character of same and depth placed, from feet to feet for each plug set.

Filled hole with heavy rotary mud from 4,665 feet (rotary total depth) to 300 feet. Set plug at 300 feet and cemented with 35 sxs cement. Filled hole with heavy rotary mud from 300 feet to 40 feet. Set solid plug at 40 feet and cemented to cellar with 15 sxs cement, 2 sxs cement in rathole.

Plugging operations accomplished utilizing Halliburton Oil Well Pump Truck through 4 1/2 inch drill pipe.

(If additional description is necessary, use BACK of this sheet)
Name of Plugging Contractor H-30, INC.
Address 200 North Main Wichita, Kansas 67202

STATE OF Kansas COUNTY OF Sedgwick ss.
Dean Britting - Agent

(Signature of owner) or (Signature of agent) of the above-described well, being first duly sworn on oath, says: That I have knowledge of the facts, statements, and matters herein contained and the log of the above-described well as filed and that the same are true and correct. So help me God.

(Signature) Dean Britting
200 North Main Wichita, Ks. 67202
(Address)

Subscribed and Sworn to before me this 26th day of February, 1976

My commission expires June 30, 1978

Elsie Willison -- Notary Public.



COMPANY **The National Oil Company**
FARM **Simon** NO. **1**

SEC. **21** T. **29S** R. **10W**
LOC. **SE NW SE**

TOTAL DEPTH **4,665'**
COMM. **February 11, 1976** COMP. **February 23, 1976**
SHOT OR TREATED
CONTRACTOR **H-30, INC.**
ISSUED **February 26, 1976**

COUNTY **Kingman**
KANSAS

CASING
20 10
15 8 **5/8" 345' cemented w/ 300 sxs cement** ELEVATION **1,733'KB**
12 6
13 5
PRODUCTION

FIGURES INDICATE BOTTOM OF FORMATIONS

Soil and Sand	35'
Shale	348'
Red Bed and Shale	770'
Shale	1,775'
Lime and Shale	3,695'
Lime	4,665'
Rotary Total Depth	4,665'

RECEIVED
STATE CORPORATION COMMISSION
FEB 27 1976
CONSERVATION DIVISION
Wichita, Kansas

I hereby certify the above and foregoing to be
a true and correct log of the above described well
as shown by the drilling reports.

H-30, INC.

Dean Britting
Dean Britting

State of Kansas }
County of Sedgwick } ss:

Subscribed and Sworn to before me a Notary Public
in and for said county and state this 26th day of Febru-
ary, 1976.

NOTARY
JUNE 30, 1978

Elsie Willison
Elsie Willison - Notary Public

My Commission Expires:
June 30, 1978