


15-189-00017-0000

STATE OF KANSAS
STATE CORPORATION COMMISSION
Information Completely
Required Affidavit
Must be Delivered Report to:
Conservation Division
State Corporation Commission
212 North Market, Insurance Bldg.
Wichita, Kansas

WELL PLUGGING RECORD

Stevens County. Sec. 18 Twp. 32S Rge. XX 36 (W)
Location as "NE/CNW/SW" or footage from lines C SW SE
Lease Owner Shell Oil Company
Lease Name CITIZENS STATE BANK Area 16 Well No. 1-18
Office Address P. O. Box 744, Great Bend, Kansas
Character of Well (completed as Oil, Gas or Dry Hole) Dry Hole
Date well completed October 28 1959
Application for plugging filed November 4 1959
Application for plugging approved (Verbal) October 28 1959
Plugging commenced October 29 1959
Plugging completed October 29 1959
Reason for abandonment of well or producing formation _____

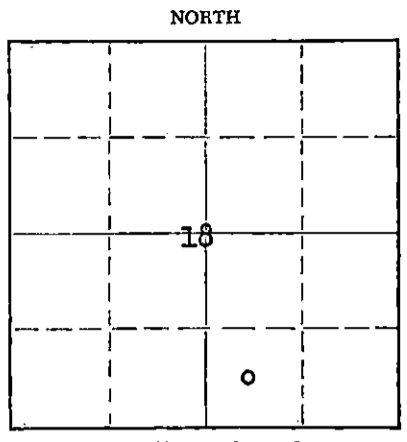

Locate well correctly on above Section Plat

If a producing well is abandoned, date of last production _____ 19____
Was permission obtained from the Conservation Division or its agents before plugging was commenced? Yes

Name of Conservation Agent who supervised plugging of this well Merle A. Rives
Producing formation Mississippian Depth to top 6103 Bottom _____ Total Depth of Well 6298 Feet
Show depth and thickness of all water, oil and gas formations.

OIL, GAS OR WATER RECORDS					CASING RECORD	
FORMATION	CONTENT	FROM	TO	SIZE	PUT IN	PULLED OUT

Describe in detail the manner in which the well was plugged, indicating where the mud fluid was placed and the method or methods used in introducing it into the hole. If cement or other plugs were used, state the character of same and depth placed, from _____ feet to _____ feet for each plug set.

Hole full of heavy rotary mud.
Pumped in 150 sax cement by Halliburton, Leaving plug 2930-2380.
Pushed 8-5/8" Halliburton plug to 590.
Capped plug with 20 sax cement to 528.
Pushed 8-5/8" Halliburton plug to 35.
Capped plug with approximately 10 sax cement to 5' below ground level.

6298-2930 PB w/ mud
2930-2380 PB w/ cement
2380- 590 PB w/ mud
590- 528 PB w/ cement
528- 35 PB w/ mud
35- 0 PB w/ cement

RECEIVED
STATE CORPORATION COMMISSION
NOV 9 1959
CONSERVATION DIVISION
Wichita, Kansas

(If additional description is necessary, use BACK of this sheet)
Name of Plugging Contractor Company Rig No. 18 (w/ Halliburton)
Address P. O. Box 744, Great Bend, Kansas

STATE OF KANSAS, COUNTY OF BARTON, ss.
A. W. Weber (employee of owner) or (owner or operator) of the above-described well, being first duly sworn on oath, says: That I have knowledge of the facts, statements, and matters herein contained and the log of the above-described well as filed and that the same are true and correct. So help me God.

(Signature) A W Weber
P. O. Box 744, Great Bend, Kansas
(Address)

SUBSCRIBED AND SWORN TO before me this 4th day of November 19 59

My commission expires January 28, 1961 L. Mont Byers Jr. Notary Public.

SHELL-CITIZENS STATE BANK Area 16 No. 1-18
C SW SE Section 18-32S-36W
Wildcat (Hugoton)
Stevens County, Kansas

Casing Record

8-5/8" cem 627 with 450 sax; cem. circ.

- 0 - 565 surface clay & sand
- 807 red bed
- 1537 red bed w/ anhydrite & sand
- 1945 red bed w/ anhydrite streaks
- 1972 red bed
- 2320 red bed w/ anhydrite & sand
- 2498 shale & anhydrite
- 2629 anhydrite w/s shale
- 2752 shale & anhydrite
- 2907 lime w/ shale
- 3342 lime
- 3392 shale
- 3684 lime
- 3798 shale & lime
- 3975 lime
- 4087 lime & shale Top Heebner 4138
- 4687 lime Top Toronto 4184
- 4764 shale & lime Top Lansing-Kansas City 4307
- 5315 lime Top Marmaton 5017
- 5384 shale w/s lime Top Cherokee 5209
- 5454 shale w/ lime Top Chester 6103
- 5647 shale
- 5742 shale w/ lime
- 5846 shale
- 5969 shale & lime
- 6082 shale w/ sand & lime
- 6117 shale
- 6182 shale & lime
- 6298 lime T.D.

- Log tops: Topeka 3371
- Heebner 4148
- Toronto 4210
- LKC 4312
- Morrow Shale 5721
- Morrow Sand 6002
- St. Genevieve 6240

STATE OF KANSAS)
) SS
COUNTY OF BARTON)

I hereby affirm that the above and fore-
going is a true and correct copy of the
drillers' log of the Citizens' State Bank Area
16 No. 1-18 well, located in Section 18-32S-36W,
Stevens County, Kansas

Shell Oil Company

By *A. W. Weber*
Superintendent

Subscribed and sworn to before me a Notary
Public this 4th day of November, 1959.

Edmont Byers, Jr.
Notary Public

My commission expires: January 28, 1961.

RECEIVED
CONSERVATION DIVISION
Wichita, Kansas