


Give All Information Completely
Make Required Affidavit
Mail or Deliver Report to:
Conservation Division
State Corporation Commission
211 No. Broadway
Wichita, Kansas

WELL PLUGGING RECORD

Stevens County, Sec. 13 Twp 32 S Rge. (E) 35 (W)

Location as "NE/CNW/SW" or footage from lines NW SE
Lease Owner Aikman Bros. Corporation
Lease Name Larrabee Well No. 1
Office Address 706 Bank of the Southwest Bldg., Amarillo, Texas 79101
Character of Well (completed as Oil, Gas or Dry Hole) Lost well
Date well completed October 17 19 67
Application for plugging filed October 17 19 67
Application for plugging approved October 17 19 67
Plugging commenced 3:00 p.m. October 17 19 67
Plugging completed 4:00 p.m. October 17 19 67
Reason for abandonment of well or producing formation Bottom 2 its. of surface pipe parted, could not drill through them.

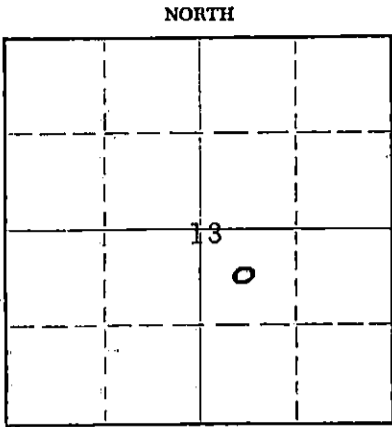

Locate well correctly on above Section Plat

If a producing well is abandoned, date of last production 19
Was permission obtained from the Conservation Division or its agents before plugging was commenced? Yes

Name of Conservation Agent who supervised plugging of this well Ed Eves, Sublette, Kansas
Producing formation Depth to top Bottom Total Depth of Well 2926 Feet
Show depth and thickness of all water, oil and gas formations.

OIL, GAS OR WATER RECORDS

CASING RECORD

FORMATION	CONTENT	FROM	TO	SIZE	PUT IN	PULLED OUT
				8-5/8"	1714'	-0-

Describe in detail the manner in which the well was plugged, indicating where the mud fluid was placed and the method or methods used in introducing it into the hole. If cement or other plugs were used, state the character of same and depth placed, from feet to feet for each plug set.

Cemented through open end drill pipe, 35 sx. from 700' to 600' and with 15 sx. from 45' to bottom of cellar.

RECEIVED
STATE CORPORATION COMMISSION
OCT 24 1967
CONSERVATION DIVISION
Wichita, Kansas

(If additional description is necessary, use BACK of this sheet)

Name of Plugging Contractor Rine Drilling Company, Inc.
Address Suite 600 - 300 West Douglas - Wichita, Kansas 67202


STATE OF KANSAS, COUNTY OF SEDGWICK, ss. on
R. M. Green, Officer of Drilling Contractor (employee or owner or owner or operator) of the above-described well, being first duly sworn on oath, says: That I have knowledge of the facts, statements, and matters herein contained and the log of the above-described well as filed and that the same are true and correct. So help me God.

(Signature) R. M. Green
Suite 600 - 300 West Douglas - Wichita, Kansas 67202
(Address)

SUBSCRIBED AND SWORN TO before me this 23rd day of October 19 67

My commission expires June 8, 1970

Bette J. Edwards
Bette J. Edwards Notary Public

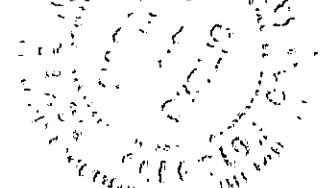

NW SE
SECTION 13-32S-35W
STEVENS COUNTY, KANSAS

LARRABEE WELL NO. 1

CONTRACTORS: RINE DRILLING COMPANY, INC.

STARTED: OCTOBER 11, 1967 COMPLETED: OCTOBER 17, 1967

LOG

Clay	0' - 41'
Sand and Gypsum	41' - 525'
Red Bed	525' - 700'
Red Bed & Sand	700' - 1424'
Red Bed	1424' - 1770'
Red Bed & Shale	1770' - 1900'
Shale	1900' - 2320'
Shale & Anhydrite	2320' - 2516'
Shale	2516' - 2926'

Totco - 1/4° @ 550'

Ran 43 jts. 8-5/8" csg. to 1714'
w/650 sx. 50/50 poz. 6% total
Gel - 1/2# Jel-Flake 2% cc. &
150 sx. common 3% cc.

8 hrs. fishing @ 2176'
Totco 3/4° @ 2415'
5-3/4 hrs. fishing @ 2926'
Spot 35 sx. cem. plug @ 700'
Spot 15 sx. & plug 0-40'.

STATE OF KANSAS)
COUNTY OF SEDGWICK) SS.

I, R. M. Green, do hereby certify that the above is a true and accurate log of the Larrabee Well No. 1, located NW SE, Section 13-32S-35W, Stevens County, Kansas.

R. M. Green
R. M. Green, Secretary-Treasurer

Subscribed and sworn to before me this 23rd day of October, 1967.

Bette J. Edwards
Bette J. Edwards, Notary Public

My Commission Expires: 6/8/70

RECEIVED
OCT 24 1967
CONSERVATION DIVISION
Wichita, Kansas