


STATE OF KANSAS
STATE CORPORATION COMMISSION

Give All Information Completely
Make Required Affidavit
Mail or Deliver Report to:
Conservation Division
State Corporation Commission
211 No. Broadway
Wichita, Kansas

WELL PLUGGING RECORD

NORTH

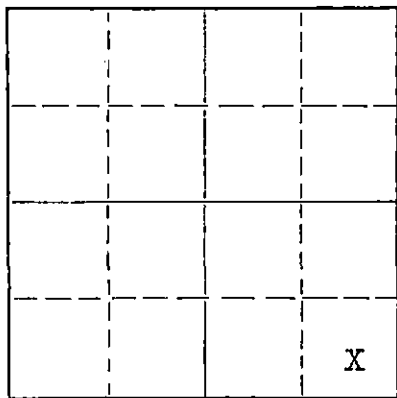

Locate well correctly on above
Section Plat

Stevens County, Sec. 24 Twp. 32S Rge. (E) 35 (W)
Location as "NE/CNW/SW" or footage from lines C-SE-SE
Lease Owner J. M. Huber Corporation SW
Lease Name Boles Well No. 1
Office Address Box 978 Liberal, Kansas
Character of Well (completed as Oil, Gas or Dry Hole) Dry Hole
Date well completed July 11 1962
Application for plugging filed July 11 1962
Application for plugging approved July 11 1962
Plugging commenced July 12 1962
Plugging completed July 12 1962
Reason for abandonment of well or producing formation Dry hole

If a producing well is abandoned, date of last production _____ 19____
Was permission obtained from the Conservation Division or its agents before plugging was commenced? yes

Name of Conservation Agent who supervised plugging of this well Mr. Hugh Scott
Producing formation None Depth to top _____ Bottom _____ Total Depth of Well 6230 Feet
Show depth and thickness of all water, oil and gas formations.

OIL, GAS OR WATER RECORDS

CASING RECORD

FORMATION	CONTENT	FROM	TO	SIZE	PUT IN	PULLED OUT
				8 5/8	2674.5	-

Describe in detail the manner in which the well was plugged, indicating where the mud fluid was placed and the method or methods used in introducing it into the hole. If cement or other plugs were used, state the character of same and depth placed, from _____ feet to _____ feet for each plug set.
Hole was filled with heavy mud to 2650'. A 30 sack cement plug set at 2650'. Hole was filled with mud to 40'. Pushed HOWCO wooden plug to 40'. filled hole with 15 sacks cement. Welded steel plate on top of casing. Job completed @ 7:15 A.M. July 12, 1962.

RECEIVED
STATE CORPORATION COMMISSION
JUL 13 1962
CONSERVATION DIVISION
WICHITA, KANSAS

(If additional description is necessary, use BACK of this sheet)
Name of Plugging Contractor D & M Drilling Company
Address 809 Union Center Wichita, Kansas

STATE OF Kansas, COUNTY OF Seward, ss.
Floyd L. Meade (employee of owner) or (owner or operator) of the above-described well, being first duly sworn on oath, says: That I have knowledge of the facts, statements, and matters herein contained and the log of the above-described well as filed and that the same are true and correct. So help me God.

(Signature) Floyd L. Meade
Box 978 Liberal, Kansas
(Address)

SUBSCRIBED AND SWORN to before me this 12th day of July, 1962

My commission expires August 5, 1964
Lydian M. Shadd Notary Public.

BOLES #1
SW 1/4 SE 1/4 Section 24-32-35
Stevens County, Kansas

Rigged up Rotary Tools June 18, 1962

Ran 21 Jts. 8-5/8" 24#, total run - 71 Jts.
Meas. 2676.73 DV tool @ 835'. Set @ 2675'
Cemented bottom stage w/875 sacks Posmix
w/2% cc. Plug didn't set. Recemented bottom
stage w/360 sacks Posmix w/2% cc. Cemented
top stage w/480 sacks Posmix w/2% cc

Set plug @ 2650', cemented w/35 sacks
cement. Filled hole with heavy mud to
40'. Set plug @ 40', cemented w/15 sacks
cement.

Tore down Rotary Tools June 12, 1962

FORMATION	FROM	TO
Sand & Red Bed	0	1120
Shale & Anhydrite	1120	2131
Lime & Shale	2131	2287
Lime	2287	3785
Lime & Shale	3785	3843
Lime	3843	4027
Lime & Shale	4027	4516
Lime	4516	5199
Lime & Shale	5199	5760
Shale, Lime & Sand	5760	5863
Lime & Shale	5863	6141
Lime	6141	6230

RTD
D & A

STATE OF KANSAS
COUNTY OF SEDGWICK

I, Don S. Packer, do hereby certify that the foregoing is true and correct
to the best of my knowledge and belief.

Don S. Packer

Don S. Packer

Subscribed and sworn to before me this 13th day of July, 1962.

Adela Petrik

Adela Petrik, Notary Public

My Commission Expires:
November 5, 1962

RECEIVED
STATE CORPORATION COMMISSION

JUL 19 1962

CONSERVATION DIVISION
Wichita, Kansas