


STATE OF KANSAS
STATE CORPORATION COMMISSION

WELL PLUGGING RECORD

Give All Information Completely
Make Required Affidavit
Mail or Deliver Report to:
Conservation Division
State Corporation Commission
212 North Market, Insurance Bldg.
Wichita, Kansas

Stevens County. Sec. 27 Twp. 32S Rge. (E) 35 (W)
Location as "NE/CNW/SW" or footage from lines C NE SW
Lease Owner Shell Oil Company
Lease Name MOORE Area 8 Well No. 1-27
Office Address P. O. Box 744, Great Bend, Kansas
Character of Well (completed as Oil, Gas or Dry Hole) Dry Hole
Date well completed December 20 19 59
Application for plugging filed January 13 19 60
Application for plugging approved (verbal) December 21 19 59
Plugging commenced December 21 19 59
Plugging completed December 21 19 59
Reason for abandonment of well or producing formation _____

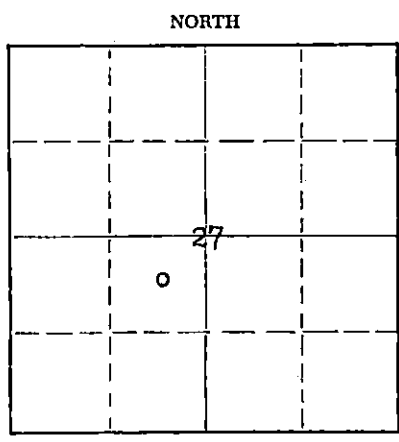

Locate well correctly on above
Section Plat

If a producing well is abandoned, date of last production _____ 19 _____
Was permission obtained from the Conservation Division or its agents before plugging was commenced? Yes

Name of Conservation Agent who supervised plugging of this well Frank Broadfoot
Producing formation Mississippian Depth to top 5925 Bottom _____ Total Depth of Well 6220 Feet
Show depth and thickness of all water, oil and gas formations.


OIL, GAS OR WATER RECORDS

CASING RECORD

FORMATION	CONTENT	FROM	TO	SIZE	PUT IN	PULLED OUT
Mississippian	Dry	5925	6220	8 5/8"	653'	None

Describe in detail the manner in which the well was plugged, indicating where the mud fluid was placed and the method or methods used in introducing it into the hole. If cement or other plugs were used, state the character of same and depth placed, from _____ feet to _____ feet for each plug set.

Hole full of heavy rotary mud. Circulated
45 minutes at 2808. Pumped in 150 sax
cement by Halliburton, leaving plug 2808-2320
Pushed 8 5/8" Howco plug to 540. Capped plug
w/ 30 sax cement to 446. Pushed 8 5/8" Howco
plug to 60. Capped plug w/ 20 sax cement to
top.
6220 - 2808 PB w/ mud
2808 - 2320 PB w/ cement
2320 - 540 PB w/ mud
540 - 446 PB w/ cement
446 - 60 PB w/ mud
60 - 0 PB w/ cement

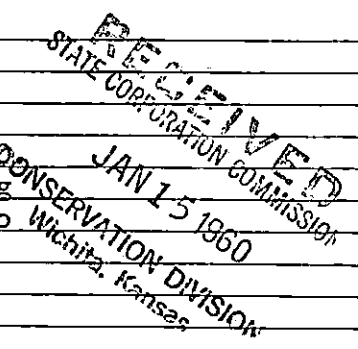

(If additional description is necessary, use BACK of this sheet)

Name of Plugging Contractor Company Rig No. 18 (w/ Halliburton)
Address P. O. Box 744, Great Bend, Kansas

STATE OF KANSAS, COUNTY OF BARTON, ss.
A. W. Weber (employee of owner) or (owner or operator) of the above-described well, being first duly sworn on oath, says: That I have knowledge of the facts, statements, and matters herein contained and the log of the above-described well as filed and that the same are true and correct. So help me God.

(Signature) A W Weber
P. O. Box 744, Great Bend, Kansas
(Address)

SUBSCRIBED AND SWORN TO before me this 13th day of January, 19 60

L. Mont Byers, Jr.
Notary Public.

My commission expires January 28, 1961

SHELL-MOORE Area 8 #1-27
C NE SW Section 27-32S-35W
WILDCAT (Hugoton)
STEVENS COUNTY, KANSAS

CASING RECORD

8 5/8" cem 653 with 450 sax; cem circ.

- 0 - 653 surface
- 1805 shale w/ sand & salt
- 2381 shale & lime
- 2539 shale & anhydrite
- 3207 lime
- 3290 lime & shale
- 4256 lime
- 4312 lime & shale
- 5042 lime
- 5097 lime & shale
- 5365 lime
- 5432 lime & shale
- 5521 shale
- 5603 lime & shale
- 5640 shale & lime
- 6020 lime & shale
- 6124 shale & lime
- 6220 lime T.D.

Sample tops:

- Heebner 4170
- Toronto 4224
- Lansing-Kansas City 4323
- Marmaton 4996
- Cherokee 5203
- Morrow Shale 5611

Log tops:

- Topeka 3352
- Heebner 4164
- Toronto 4225
- Lansing-Kansas City 4330
- Marmaton 5012
- Morrow Shale 5642
- Chester 5925
- St. Genevieve 6169

STATE OF KANSAS)
) SS
COUNTY OF BARTON)

I hereby affirm that the above and foregoing is a true and correct copy of the drillers' log of the Moore Area 8 No. 1-27 well, located in Section 27-32S-35W, Stevens County, Kansas.

Shell Oil Company

By A. W. Weber
District Superintendent

Subscribed and sworn to before me a Notary Public this 13th day of January, 1960.

My commission expires: January 28, 1961.

L. Mont Burns Jr.
Notary Public

RECEIVED
JAN 15 1960
CONSERVATION DIVISION
Wichita, Kansas