

15-191-10246-0000


STATE OF KANSAS
STATE CORPORATION COMMISSION

Give All Information Completely
Make Required Affidavit
Mail or Deliver Report to:
Conservation Division
State Corporation Commission
800 Bittling Building
Wichita, Kansas

WELL PLUGGING RECORD

Sumner County, Sec. 16 Twp. 35S Rge. 3W (E) (W)

Location as "NE/CNW 1/4 SW 1/4" or footage from lines SE SW SW
Lease Owner Glenn Supply Company
Lease Name Endured Well No. 1
Office Address P. O. Box 1104, Tulsa, Oklahoma
Character of Well (completed as Oil, Gas or Dry Hole) Oil
Date well completed August 22, 19.29
Application for plugging filed August 29, 19.61
Application for plugging approved August 30, 19.61
Plugging commenced September 5, 19.61
Plugging completed September 15, 19.61
Reason for abandonment of well or producing formation Not making any oil.

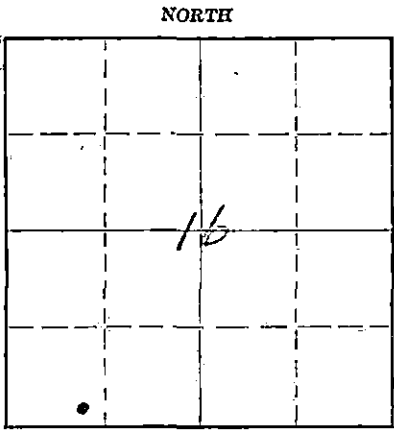

Locate well correctly on above Section Plat

If a producing well is abandoned, date of last production December 19.60
Was permission obtained from the Conservation Division or its agents before plugging was commenced? yes

Name of Conservation Agent who supervised plugging of this well Mr. Lee Guthrie, Leon, Kansas
Producing formation Wilcox Depth to top 4763 Bottom 4764 Total Depth of Well 4764 Feet
Show depth and thickness of all water, oil and gas formations.

OIL, GAS OR WATER RECORDS

CASING RECORD

Formation	Content	From	To	Size	Put In	Pulled Out
Wilcox	Oil	4763	4764	12 1/2	108	None
				8 1/4	4450	2870'
				6 5/8	4685	2965'

Describe in detail the manner in which the well was plugged, indicating where the mud fluid was placed and the method or methods used in introducing it into the hole. If cement or other plugs were used, state the character of same and depth placed, from _____ feet to _____ feet for each plug set.

Hole was originally Squeezed with 200 Sx Cement and Tubing and Cement were cemented in Hole to Depth of 3200'. 7" Casing was left full of Cement from 3200' to total depth. Ripped 7" Casing at 2965' and came out of hole. Shot 8" Casing at 2870' and came out of hole. Filled hole with mud and pumped in 100 Sx of Cement to top of hole.

(If additional description is necessary, use BACK of this sheet)

Correspondence regarding this well should be addressed to Glenn Supply Company
Address Post Office Box 1104, Tulsa, Oklahoma

Conservation Division
10-25-61

STATE OF Oklahoma, COUNTY OF Tulsa, ss.

I, Saul J. Glenn (employee of owner) or (owner or operator) of the above-described well, being first duly sworn on oath, says: That I have knowledge of the facts, statements, and matters herein contained and the log of the above-described well as filed and that the same are true and correct. So help me God.

(Signature) *Saul J. Glenn*
P. O. Box 1104, Tulsa, Oklahoma
(Address)

SUBSCRIBED AND SWORN to before me this 24 day of October, 19.61.

My commission expires April 17, 1962
Marlene Miller
Notary Public.