


15-191-10248-0000

STATE OF KANSAS
STATE CORPORATION COMMISSION

Give All Information Completely
Make Required Affidavit
Mail or Deliver Report to:
Conservation Division
State Corporation Commission
800 Bittling Building
Wichita, Kansas

WELL PLUGGING RECORD

Summer County. Sec. 16 Twp. 35S Rge. 3W (E) (W)
Location as "NE/CNW 1/4 SW 1/4" or footage from lines NW SW SW
Lease Owner Glenn Supply Company
Lease Name Endured Well No. 2
Office Address P. O. Box 1104, Tulsa, Oklahoma
Character of Well (completed as Oil, Gas or Dry Hole) Oil
Date well completed July 1, 19.30
Application for plugging filed September 15, 19.61
Application for plugging approved September 19, 19.61
Plugging commenced September 20, 19.61
Plugging completed September 26, 19.61
Reason for abandonment of well or producing formation Not making any oil.

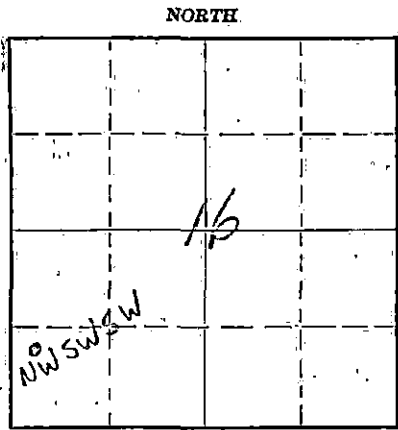

Locate well correctly on above Section Plat

If a producing well is abandoned, date of last production March 19.61
Was permission obtained from the Conservation Division or its agents before plugging was commenced? yes

Name of Conservation Agent who supervised plugging of this well Mr. Lee Guthrie, Leon, Kansas
Producing formation Wilcox Depth to top 4769 Bottom 4772 Total Depth of Well 4772 Feet
Show depth and thickness of all water, oil and gas formations.

OIL, GAS OR WATER RECORDS

CASING RECORD

Formation	Content	From	To	Size	Put In	Pulled Out
Wilcox	Oil	4769	4772	12 1/2	98	None
				8 1/4	4499	None
				7"	4736	4250

Describe in detail the manner in which the well was plugged, indicating where the mud fluid was placed and the method or methods used in introducing it into the hole. If cement or other plugs were used, state the character of same and depth placed, from feet to feet for each plug set.

No cement plugs were run on this hole and hole has not been mudded.
Ripped 7" casing at 4250' and came out of hole. We are preparing to squeeze this well and perforate it in the chat and if well is no good will finish pulling 8" casing and plugging well according to rules and regulations.

STATE CORPORATION COMMISSION
OCT 25 1961 10-25-61
CONSERVATION DIVISION
Wichita, Kansas

(If additional description is necessary, use BACK of this sheet)
Correspondence regarding this well should be addressed to Glenn Supply Company
Address Post Office Box 1104, Tulsa, Oklahoma

STATE OF Oklahoma, COUNTY OF Tulsa, ss.
I, Saul J. Glenn (employee of owner) or (owner or operator) of the above-described well, being first duly sworn on oath, says: That I have knowledge of the facts, statements, and matters herein contained and the log of the above-described well as filed and that the same are true and correct. So help me God.
(Signature) *Saul J. Glenn*
P. O. Box 1104, Tulsa, Oklahoma
(Address)

SUBSCRIBED AND SWORN to before me this 24 day of October, 1961
Maxine Miller
Notary Public.

My commission expires April 17, 1962